

U.S. PUBLIC LAND SURVEY MONUMENT RECORD

(Prepared and as required by S. A-E 7.08 WI Administrative Code)

The EAST 1/4 corner of Section 36.

Corner was: (check all that apply)

- Restored through acceptance of an obliterated evidence location.
- Restored through acceptance of a found perpetuated location.
- Determined to be lost and re-established through proportionate methods.
- Restored/recovered/reestablished in a location that differs from a previously established position. (Show difference in plan view below.)
- Check here if additional information is shown on the reverse side of this form.

Describe record evidence, recovered physical evidence, occupational evidence, testimonial evidence and all other evidence considered in the recovery/restoration of the corner.

The original corner was established in 1851 by James M. Marsh. In 1990, former surveyor Kelly for a 6"x6"x30" marble monument 10' below road surface. He set 1" iron pipe on four side of the stone monument found, and he set four ties but only measured to three of them. 10/06/98 Dave Tlusty, Dean Williams found stone in road, 0.8' below the gravel surface. This stone was probably set as part of a re-survey effort a long time ago in the Town of Pine River, but there is no written history available at this time. Three of Kelly's four ties have been destroyed by recent ditching along west side of road. I accept the location of the existing stone monument as the best evidence of the original corner location and measured ties as shown below.


Physical description of the monument set:

I left the existing stone in place. It is in good condition and still has some of Kelly's iron pipe around it.

Describe the accessories used to perpetuate the location of the corner. Include a plan view drawing and indicate accessories found/set. Describe measuring point on bearing trees. Show any topographic features that would aid in future recovery of the corner.

- = set 3/4" x 30" rebar flush with ground
- ▲ = set white vinyl sign post
- = found 1" iron pipe
- ◎ = found 2" aluminum pipe with aluminum cap.

Notes FB17-8

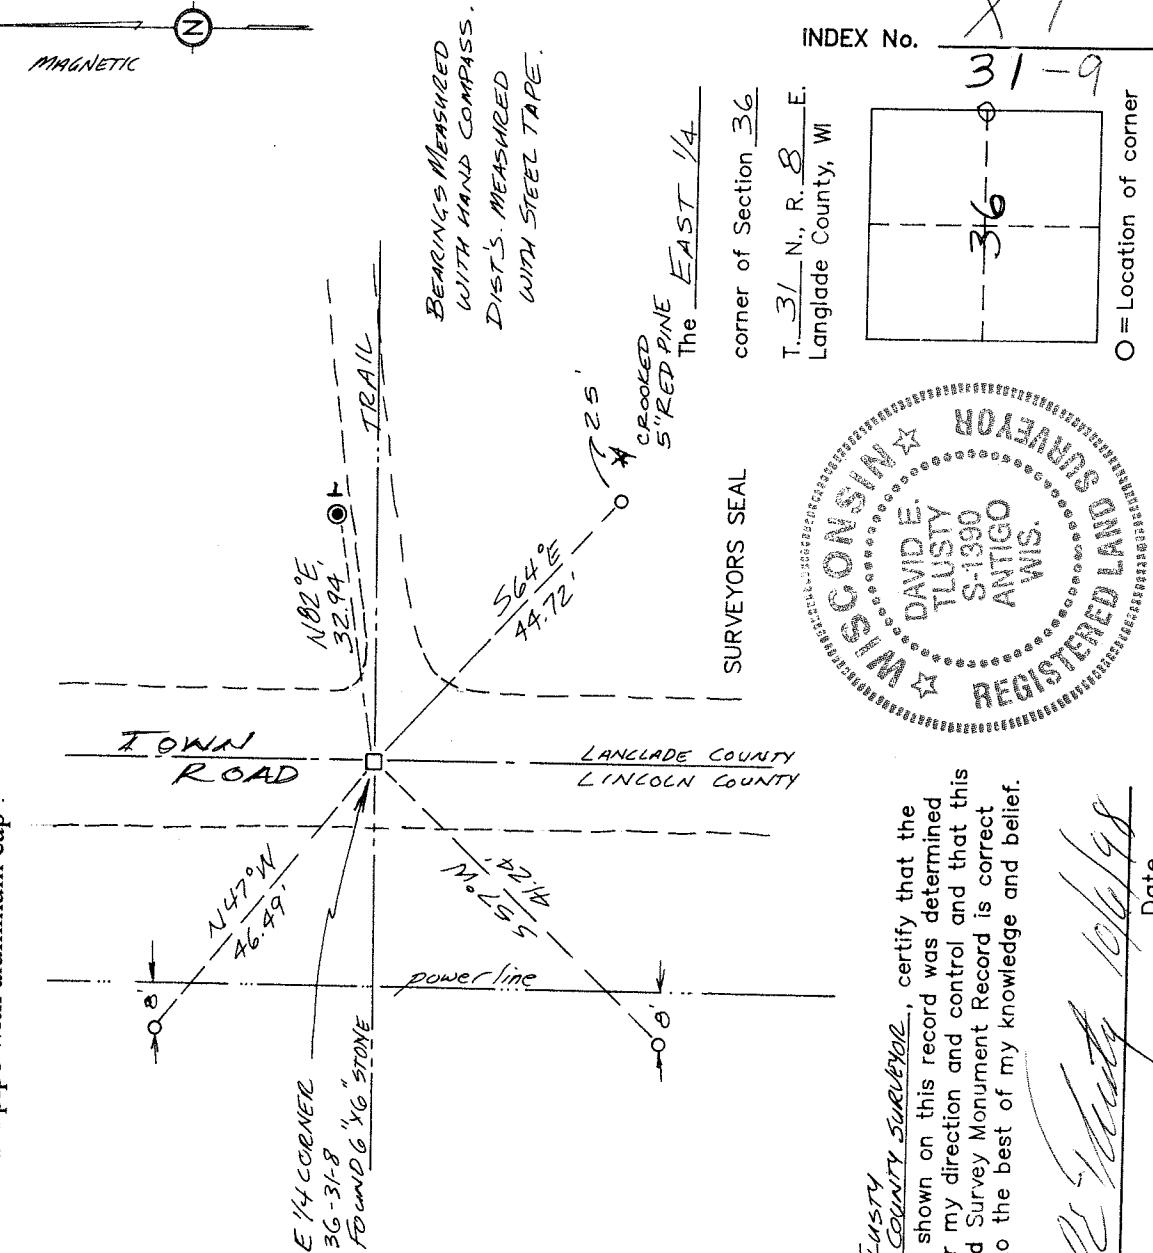

DAVID E. TLUSTY,
LANGLADE COUNTY SURVEYOR, certify that the
corner location shown on this record was determined
by me or under my direction and control and that this
U.S. Public Land Survey Monument Record is correct
and complete to the best of my knowledge and belief.

David E. Tlusty
Signature
Date

WISCONSIN ADMINISTRATIVE CODE

Note: A copy of the board-approved form is available from the Department of Regulation and Licensing, Bureau of Business and Design Professions, 1400 East Washington Avenue, P.O. Box 8925, Madison, Wisconsin 53708.

(3) MONUMENT RECORD REQUIREMENTS. A U.S. public land survey monument record shall show the location of the corner and shall include all of the following elements:

(a) The identity of the corner, as referenced to the U.S. public

land survey system;

(b) A description of any record evidence, monument evidence, occupational evidence, testimonial evidence or any other material evidence considered by the surveyor, and whether the monument was found or placed;

(c) Reference ties to at least 4 witness monuments. Witness monuments shall be concrete, natural stone, iron, bearing trees or other equally durable material, except wood other than bearing

trees;

(d) A plan view drawing depicting the relevant monuments and reference ties which is sufficient in detail to enable accurate relocation of the corner monument if the corner monument is disturbed;

(e) A description of any material discrepancy between the location of the corner as restored or reestablished and the location of that corner as previously restored or reestablished;

(f) Whether the corner was restored through acceptance of an obliterated evidence location or a found perpetuated location;

(g) Whether the corner was reestablished through lost-corner-proportionate methods;

(h) The directions and distances to other public land survey corners which were used as evidence or used for proportioning in determining the corner location; and,

(i) The stamp and signature or seal and signature of the land surveyor under whose direction and control the corner location was determined and a statement certifying that the U.S. public land survey monument record is correct and complete to the best of his or her knowledge and belief.

History: Cr. Register, February, 1987, No. 374, eff. 3-1-87; am. (1) and (3)(c), Register, May, 1989, No. 401, eff. 6-1-89.

Copy to Lincoln County 10/6/98 L.R.