

CERTIFIED LAND CORNER RESTORATION

Index No. E-21

State of Wisconsin }
County of Langlade } ss.

I Raymond J. Hallisy, do hereby certify that on the 15th day of April, 1928, I found evidence of the Section corner of 1, 2, 11, 12 Township 31, North, Range 9 EAST, Fourth Principal Meridian, as described hereon; and that from this evidence I established a new monument and accessories as described hereon to perpetuate the original location of this corner.

Resident witnesses:


History of original corner establishment:

Corner Established in 1937 Resurvey

31.9


Description of corner evidence found:

4 inch Iron Pipe with Brass cap
old B.T.
Pine stump N80°E 57.7 FT.

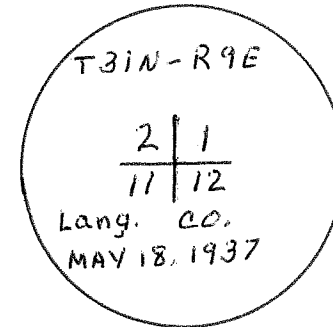

Description of monument and accessories I established to perpetuate the original location of this corner.

NEW B.T.s
WHITE OAK 12" N30°E
WHITE OAK 8" S26°E 25.9 FT.

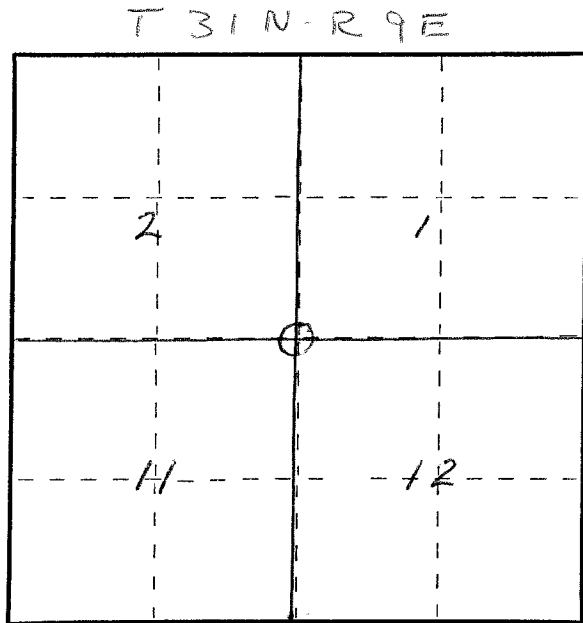

○ = Corner monument restored.

Dated at Antigo, Wis., this 15th day of April, 1928.

Signature Raymond J. Hallisy Title Registered Land Surveyor Registration No. S-685
(County Surveyor, Registered Land Surveyor, or other duly authorized official)

Office of Register of Deeds, County of _____, I hereby certify that the within instrument was filed in this office for record on the _____ day of _____, 19____ at _____ o'clock _____ M.

(Register of Deeds)

By _____ Deputy

FORM 985 H. C. MILLER CO., MILWAUKEE

4310902000