

# U.S. PUBLIC LAND SURVEY MONUMENT RECORD

(Prepared and as required by S. A-E 7.08 WI Administrative Code)

The West Quarter corner of Section 7, T. 31 N., R. 10 E., Langlade County, W

Corner was: (check all that apply)

- Restored through acceptance of an obliterated evidence location.
- Restored through acceptance of a found perpetuated location.
- Determined to be lost and re-established through proportionate methods.
- Restored/recovered/reestablished in a location that differs from a previously established position. (Show difference in plan view below.)
- Check here if additional information is shown on the reverse side of this form.

Describe record evidence, recovered physical evidence, occupational evidence, testimonial evidence and all other evidence considered in the recovery/restoration of the corner.

June of 1859, Township line between T31N, R9E and T31N, R10E by Hiram Fellows, North between Sections 7 and 12 set  $\frac{1}{4}$  post with bearing trees: Birch 6 N42°W 10 links

Burr Oak 8 S65°E 25 links 1937-resurvey of E $\frac{1}{2}$  of Township 31 North, Range 9 East by D.A. Hintz, found stone with x on top at corner with no bearing trees. Set brass cap in place of stone. No ties set.

1998-W. Dobbratz, found 4" iron pipe with brass cap and tied out:

B.T. 8" Popple S27°W 126.75' B.T. 3" black Cherry S83°E 16.42'

B.T. 7" Popple S29°W 115.64' B.T. 11" Popple S24°W 138.50'

We found 4" iron pipe where Dobbratz tied it out. After measuring from the NW cor. to the SW cor. the West  $\frac{1}{4}$  corner location did not fit the 1937 survey. Computed a search location based on 1937 notes and found a ring of stones and found stone with cross on top at search

Physical description of the monument set:

Re-set 4" x 36" iron pipe with brasscap.

Monument is in center of old roadbed and set flush with existing ground. Existing stones around monument.


Top of brass cap as stamped.

Describe the accessories used to perpetuate the location of the corner. Include a plan view drawing and indicate accessories found/set. Describe measuring point on bearing trees. Show any topographic features that would aid in future recovery of the corner.

## LEGEND

- Set 3/4" x 30" re-bar
- 4" x 36" iron pipe with brass cap
- 2" x 30" iron pipe with brass cap
- 1/2" iron bar
- ( ) 1937 re-survey notes
- SCALE: 1"=20'

Bearings referenced to Section lines shown

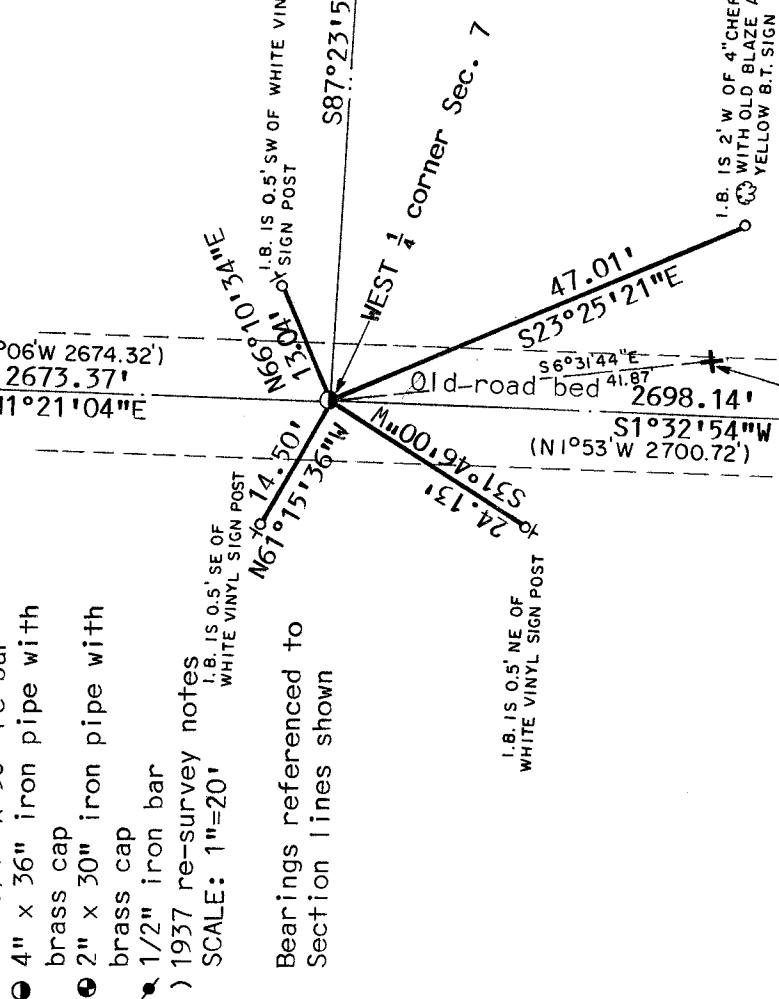


PREVIOUS LOCATION OF 4" I.P.  
WITH BRASS CAP  
West  $\frac{1}{4}$  corner

West  $\frac{1}{4}$  corner

corner of Section 7


T. 31 N., R. 10 E.

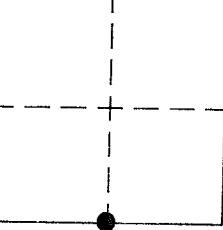

● = Location of corner

G 25  
31-09

INDEX No.

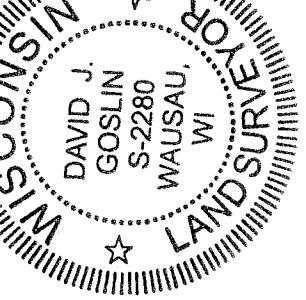

I, David J. Goslin, certify that the corner location shown on this record was determined by me or under my direction and control and that this U.S. Public Land Survey Monument Record is correct and complete to the best of my knowledge and belief.

David J. Goslin 3-28-03  
Signature Date

43log12 2000

WISCONSIN ADMINISTRATIVE CODE

Note: A copy of the board-approved form is available from the Department of Regulation and Licensing, Bureau of Business and Design Professions, 1400 East Washington Avenue, P.O. Box 8935, Madison, Wisconsin 53708.

(3) MONUMENT RECORD REQUIREMENTS. A U.S. public land survey monument record shall show the location of the corner and shall include all of the following elements:

(a) The identity of the corner, as referenced to the U.S. public land survey system;

(b) A description of any record evidence, monument evidence, occupational evidence, testimonial evidence or any other material evidence considered by the surveyor, and whether the monument was found or placed;

(c) Reference ties to at least 4 witness monuments. Witness monuments shall be concrete, natural stone, iron, bearing trees or other equally durable material, except wood other than bearing trees;

(d) A plan view drawing depicting the relevant monuments and reference ties which is sufficient in detail to enable accurate relocation of the corner monument if the corner monument is disturbed;

(e) A description of any material discrepancy between the location of the corner as restored or reestablished and the location of that corner as previously restored or reestablished;

(f) Whether the corner was restored through acceptance of an obliterated evidence location or a found perpetuated location;

(g) Whether the corner was reestablished through lost-corner-proportionate methods;

(h) The directions and distances to other public land survey corners which were used as evidence or used for proportioning in determining the corner location; and,

(i) The stamp and signature or seal and signature of the land surveyor under whose direction and control the corner location was determined and a statement certifying that the U.S. public land survey monument record is correct and complete to the best of his or her knowledge and belief.

History: Cr. Register, February, 1987, No. 374, eff. 3-1-87; am. (1) and (3)(c), Register, May, 1989, No. 401, eff. 6-1-89.

location. Location fit 1937 survey notes well. Moved and re-set 4" x36" iron pipe with brass cap in center of ring of stones and set stone with cross along side the iron pipe. Monument is set flush with ground and falls in center of old road bed.