
OFFICIES	1 8 5 1 25	CODALED	DECECOLATION	
CERTIFIED	LAND	CORNER	RESTORATION	

Index No	o. F	7-15	5
	2	1-9	

State	of	Wisconsin	1	
County of	Lan	glade	}	ss.

Resident witnesses:

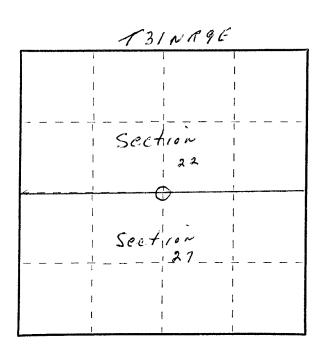

O = Corner monument restored.

History of original corner establishment:

Corner set in the 1930 resurvey.

Description of corner evidence found:

4" iron pipe with brass one south of State Highway "64"

Description of monument and accessories I established to perpetuate the original location of this corner.

PT's to witness Corner.

731 N R 9E 145 -22 RSH 22 RSH 23 11/5/22 LANG Co MAY 13, 1937 COP. 30F1 N

Dated at	Antigo	V	Vis., this	5th	day of	Movember	
Signature	aynend &	allery	Title	Land	Surveyor	Registra	ntion No. 8685
Office of Res	(County Survey	or, Registered I	Land Surveyo	or, or other	duly authorized of	fficial) 	tify that the within
instrument v	was filed in this off	ice for/record	on the	**********	day c	of	, 19
ato	'clock	M.					
	(Regis	ter of Deeds)					