

CERTIFIED LAND CORNER RESTORATION

Index No. P-17
21-9

State of Wisconsin }
County of Langlade } ss.

I Raymond J. Hallisy, do hereby certify that on the 5th day of November, 1977, I found evidence of the ~~XXXX~~ 1/4 corner of 22 & 23 Township 31 9E, North, Range 9E, Fourth Principal Meridian, as described hereon; and that from this evidence I established a new monument and accessories as described hereon to perpetuate the original location of this corner.

Resident witnesses:

.....
.....
.....

History of original corner establishment:

Corner set in the 1930 resurvey.


Description of corner evidence found:

4" iron pipe with brass cap east of town road.

Description of monument and accessories I established to perpetuate the original location of this corner.

Set steel fence post alongside Witness Corner.
New ET's to Witness Corner

7" Spruce N38E 81.4 Ft.
5" Spruce S70E 114 Ft.

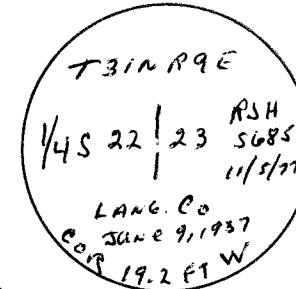


Dated at Antigo, Wis., this 5th day of November, 1977.

Signature Raymond J. Hallisy Title Land Surveyor Registration No. 5685
(County Surveyor, Registered Land Surveyor, or other duly authorized official)

Office of Register of Deeds, County of Langlade, I hereby certify that the within instrument was filed in this office for record on the 5th day of November, 1977 at 10 o'clock AM.

.....
(Register of Deeds)
By.....Deputy

FORM 985 H. C. MILLER CO., MILWAUKEE
43109272000
61917

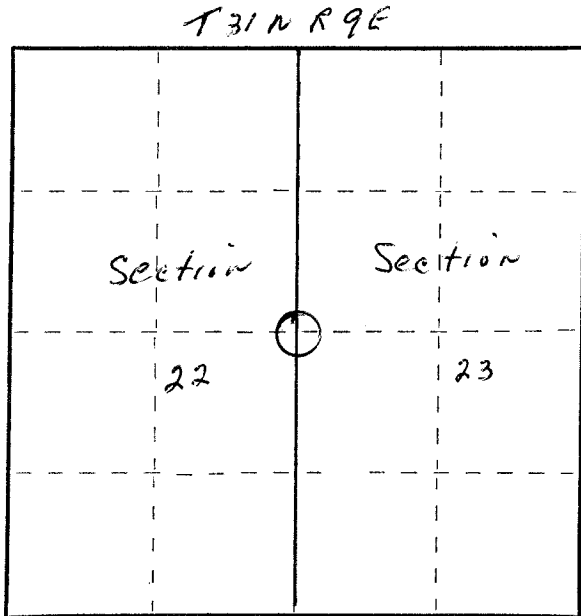

○ = Corner monument restored.