

CERTIFIED LAND CORNER RESTORATION

31-9
Index No. 0-17

State of Wisconsin }
County of Langlade } ss.

I, Raymond J. Hallisy, do hereby certify that on the 25th day of July, 1970, I found evidence of the N 1/16 corner of Section 22 Township 31, North, Range 9E, Fourth, Principal Meridian, as described hereon; and that from this evidence I established a new monument and accessories as described hereon to perpetuate the original location of this corner.

Resident witnesses:

History of original corner establishment:

Corner set in the 1930 resurvey

Description of corner evidence found:



Found old stake standing about 150 Ft. west of town road. Marked 23 22 1/8. This ~~agrees~~ agrees with field notes.

Description of monument and accessories I established to perpetuate the original location of this corner.

Set 2" pipe with brass cap, rock mound.

New B.T.'s
8" Aspen N66W 33 Ft. 6 Inches
6" Aspen N44W 32 Ft. 2 Inches

B? T.'s faced at base of tree and scribed BT.

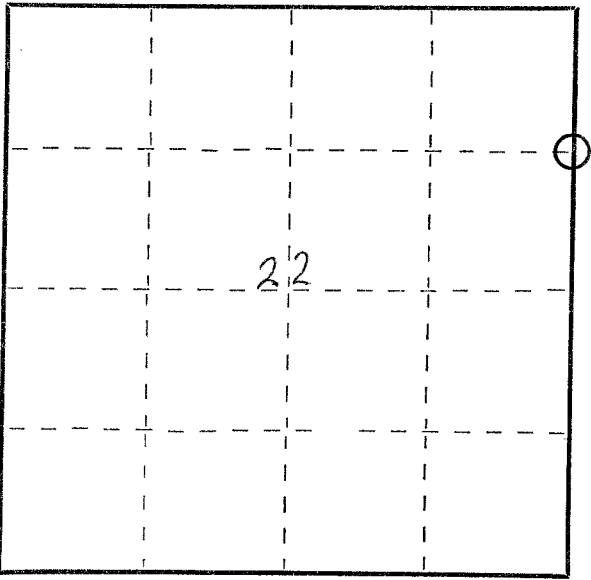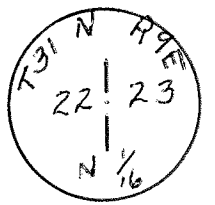

○ = Corner monument restored.

Dated at Antigo, Wis., this 25th day of July, 1970

Signature Raymond J. Hallisy Title Reg. Land Surveyor Registration No. S-685
(County Surveyor, Registered Land Surveyor, or other duly authorized official)

Office of Register of Deeds, County of _____, I hereby certify that the within instrument was filed in this office for record on the _____ day of _____, 19____ at _____ o'clock _____ M.

(Register of Deeds)

By _____ Deputy

FORM 985 H. C. MILLER CO., MILWAUKEE

43109223000