

CERTIFIED LAND CORNER RESTORATION

Index No. 2-7

State of Wisconsin }
County of Lan glade } ss.

I Anthony B. Kiedrowski, do hereby certify that on the 18th day of January, 1978, I found evidence of the S¹/₄ corner of Section 32 Township 31, North, Range 9, Fourth Principal Meridian, as described hereon; and that from this evidence I established a new monument and accessories as described hereon to perpetuate the original location of this corner.

History of original corner establishment:

June, 1851, James Marsh set a wood post for the original corner.
June, 1937, D.A. Hintz set a 3" iron pipe with a brass cap.

Description of corner evidence found:


Found existing 3" iron pipe with brass cap.

Resident witnesses:


.....
.....
.....

Description of monument and accessories I established to perpetuate the original location of this corner

SEE REVERSE SIDE.

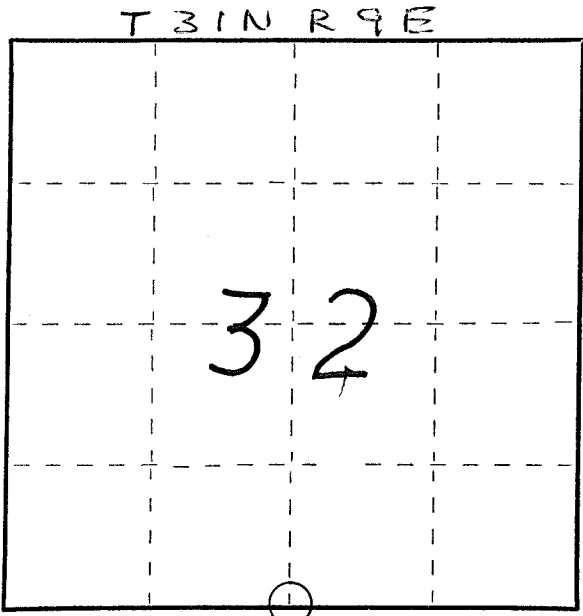

○ = Corner monument restored.

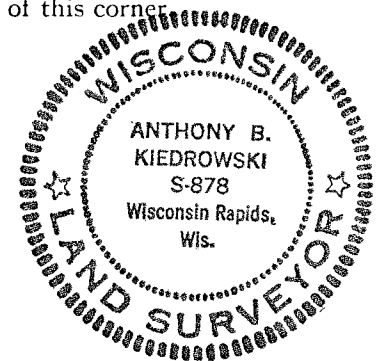

Dated at Wisc. Rapids, Wis., this 21st day of February, 1978.

Signature Anthony B. Kiedrowski Title R.L.S. Registration No. 878
(County Surveyor, Registered Land Surveyor, or other duly authorized official)

Office of Register of Deeds, County of....., I hereby certify that the within instrument was filed in this office for record on the..... day of....., 19..... at..... o'clock..... M.

.....
(Register of Deeds)

By..... Deputy

FORM 985 H. C. MILLER CO., MILWAUKEE
43109320020

43109320070

Ties are to nail and disc driven into tree.

