State of Wisconsin

\$-878 Wisconsin Rapids

History of original corner establishment:

June 1851, James Marsh set post for original corner.

June 8,1937, D.A. Hintz set 3" iron pipe with brass cap.

Description of corner evidence found:

Found 3" pipe by Hintz knocked out and lying on top of ground. Corner reset by computed traverse from adjacent corners, allowing for curvature of standard parallel.

Description of monument and accessories I established to perpetuate the original location of this corner see above

Reset 3" iron pipe found.


ANTHONY B. KIEDROWSKI

See reverve side.

Dated at Wis. Rapids,	, Wis., this	February of	78
Signature A & Kalles L (County Surveyor, Register			
Office of Register of Deeds, County of instrument was filed in this office for rec	***************************************	, I hereby certify t	that the within
it		*	

(Register of Deeds)

Ties are to nail and brass disc. Trees are scribed BT.

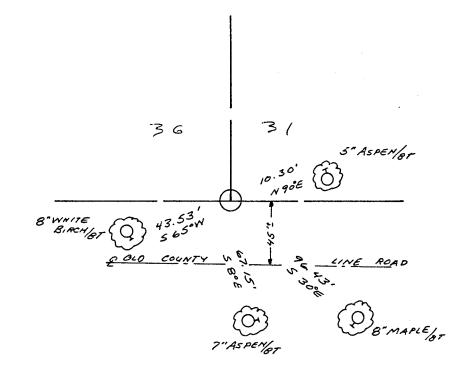

FIELD BOOK 61 PAGE 50