

CERTIFIED LAND CORNER RESTORATION

Index No. Z-23

State of Wisconsin }
County of Langlade } ss.

I A. B. KIEDROWSKI, do hereby certify that on the 7th day of FEB., 19 78, I found evidence of the SOUTH 1/4 corner of SEC. 36 Township 31, North, Range 9, Fourth Principal Meridian, as described hereon; and that from this evidence I established a new monument and accessories as described hereon to perpetuate the original location of this corner.

Resident witnesses:

.....
.....
.....

History of original corner establishment:

June, 1851, James Marsh set post for original corner.
June, 1937, D.A. Hintz set 3" iron pipe with brass cap.


Description of corner evidence found:

Area has been recently bulldozed. Could not find any evidence of the corner.

Description of monument and accessories I established to perpetuate the original location of this corner.

Corner reset by computed traverse from adjacent found corners, allowing for curvature of standard parallel per Manual of instructions. Set 2" iron 44" long with brass cap.

See reverse side.

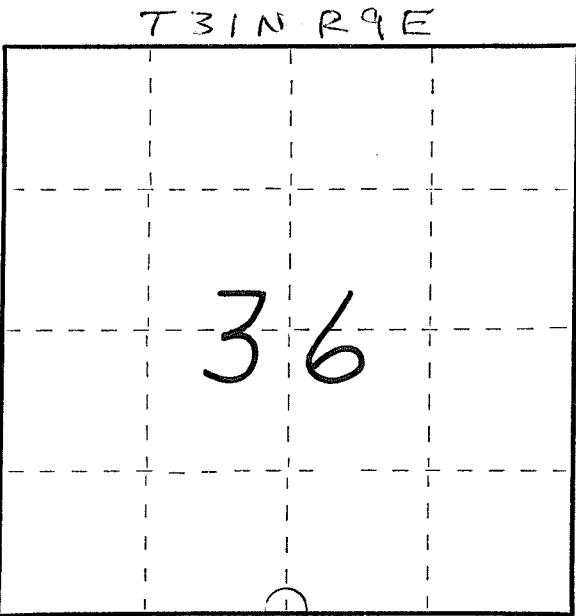


○ = Corner monument restored.

Dated at Wis. Rapids, Wis., this 10th day of February

Signature A. B. Kiedrowski Title R. L. S. Registration No. 878
(County Surveyor, Registered Land Surveyor, or other duly authorized official)

Office of Register of Deeds, County of....., I hereby certify that the within instrument was filed in this office for record on the..... day of....., 19..... at..... o'clock..... M.

.....
(Register of Deeds)
By..... Deputy

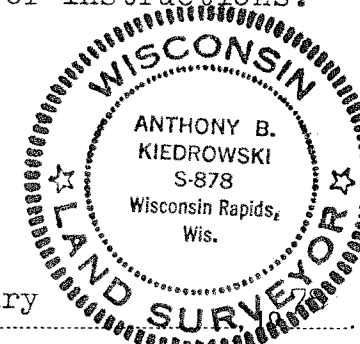

FORM 985 H. C. MILLER CO., MILWAUKEE

43169360020

43109360020

Ties are to nail and brass disc.
Trees are scribed BT.

