


43110a40020

U. S. PUBLIC LAND SURVEY MONUMENT RECORD

INSTRUCTIONS:

This record shall show the location of the corner and shall include all of the following nine elements (a through i).

- (a) Identify the corner by reference to the U.S. public land survey system.
- O = Corner monument restored.

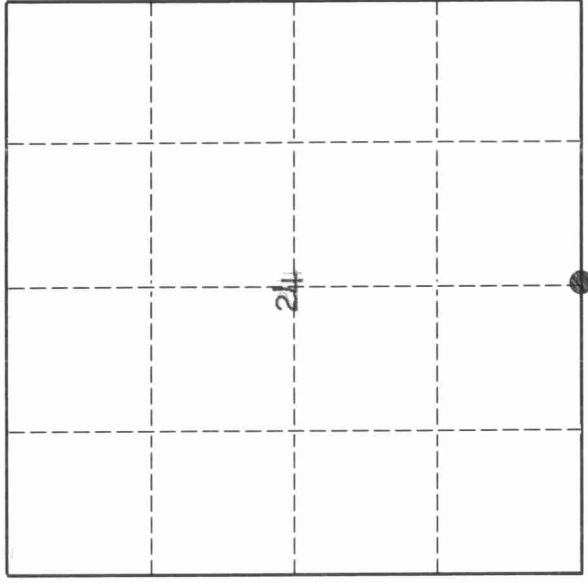

1/4 Corner sections 24 and 25


T31N, R10E

(SEE ADDITION ON BACK)

- (b) Describe any record evidence, monument evidence, occupational evidence, testimonial evidence or any other material evidence you considered, and whether the monument was found or placed.

No record evidence, no monument evidence. Made measurements from old fence lines to the west. Used old line heading south and centerline of the road as best possible evidence. Road was built a little north to take out a curve. R.R. spike is in the south lane.

- (c) In the plan view drawing below, provide reference ties to at least 4 witness monuments, or, if the location is within a municipality, to at least 2 witness monuments. (Witness monuments shall be made of concrete, natural stone, iron or other equally durable material.) Describe witness monuments.

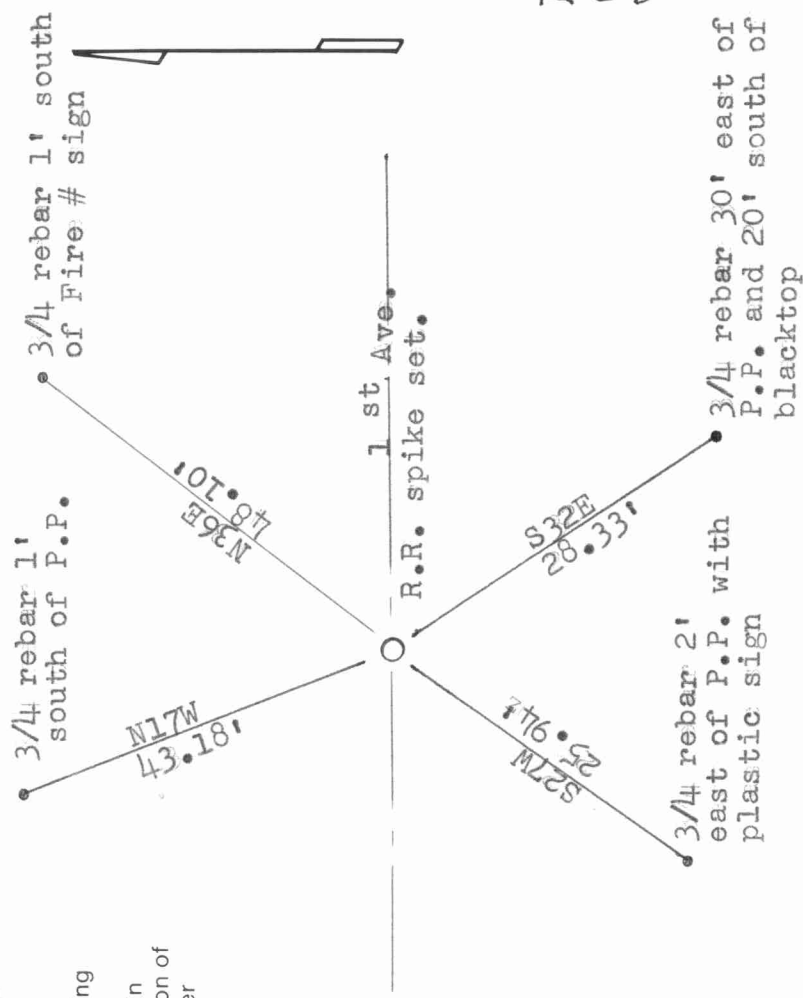

R 23

- (d) Show a plan view drawing depicting the relevant monuments and reference ties which is sufficient in detail to enable accurate relocation of the corner monument if the corner monument is disturbed. Indicate north.

43110240070

Describe any material discrepancy between the location of the corner as restored or reestablished and the location of that corner as previously restored or reestablished by distance and direction. Show the discrepancy on the plan view drawing under (d), above. Show the distances between the corner as previously restored or reestablished and (1) the corner as restored or reestablished, and (2) to at least 2 of the witness monuments shown on the drawing in (d), above.

N/A

(f) Was the corner restored through acceptance of (1) an obliterated evidence location, or, (2) a found perpetuated location?
No. 1

(g & h) Was the corner reestablished through lost corner proportionate methods? If so, show the method, including the directions and distances to other public land survey corners used as evidence or used for proportioning in determining the corner location.

No

06/26/02 Addendum to Tom Arnott 1992 corner form for the S1/4 corner 24-31-10.

Thomas Arnott
06/26/02
FB 11-1-28

1878, L. Deleglise "from 1/4 bet. 24 & 25, west random, int. 188 lks. S. of orig. Fnd. point of orig. East, set stakes over and blazed."

1880, L. Deleglise "from 1/4 cor W 40.97' (2704.02'). Deleglise mentioned 6 RT's here including 1 orig pine. Dean Williams, S2468, in 2001, measured 2708.91'.

1888, B.F. Dorr "N1/4 cor E, 39.00 (2574') Dean Williams measured 2610.75'.

1888, B.F. Dorr "N1/4 cor S, 37.935 (2503.71') Matt Rigel, S2321, measured 2508.95' to the center of Section 25.

May 25, 2002 Joseph Steagall, longtime adjoining landowner, said that when he moved here, 1968±, there was a fence line to the north, starting at the road and lining up with the fence to the south. He also indicated that when this road was rebuilt in 1970±, it was moved to the north to take out a sharp bend here.

May 25, 2002 D. Tlusty, Mike Kielcheski dug with County backhoe, 11' wide N-S and approx 16' wide E-W, approximately centered on the existing corner. Dug 3-4' deep, approx. 1' into the original ground. Found nothing. Accepted corner set by Tom Arnott as the best evidence of the original corner location.

(i) I, Thomas Arnott, S-887

(type or print name)

certify that the corner location shown on this record was determined by me or under my direction and control and that this U.S. Public Land Survey Monument Record is correct and complete to the best of my knowledge and belief.

Thomas Arnott
Signature

9 Dec. 1992
Date

