


4311060000

U. S. PUBLIC LAND SURVEY MONUMENT RECORD

INSTRUCTIONS:

This record shall show the location of the corner and shall include all of the following nine elements (a through i).

- (a) Identify the corner by reference to the U.S. public land survey system.
- = Corner monument restored.

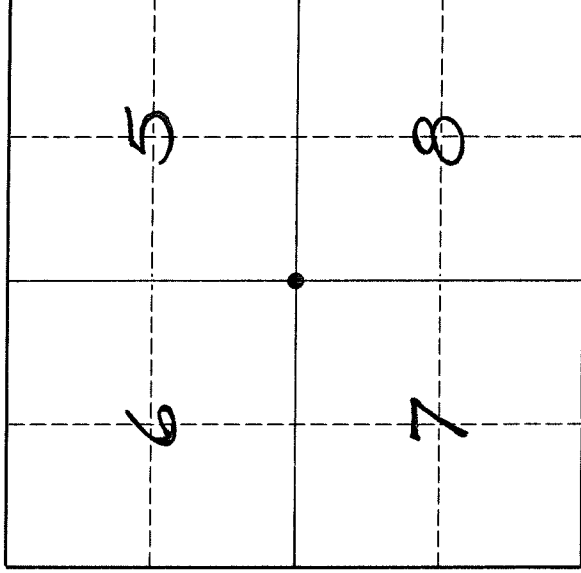

Southwest corner of
 Section 5,
 Township 31 North,
 Range 11 East,
 Langlade County,
 Wisconsin.

T. 31 N., R. 11 E.

- (b) Describe any record evidence, monument evidence, occupational evidence, testimonial evidence or any other material evidence you considered, and whether the monument was found or placed.

The original corner was established in 1860 by Hiram C. Fellows, Deputy Surveyor. Original BT's: Sugar, 10", S81W, 24 lks and an Ironwood, 8", S70E, 37 lks.

May, 1938, Malcolm Hutchinson found an old drag tooth for the corner. He set a well point, N54W, 46 1/2', and broken glass around corner. September, 1992, I found the drag tooth and glass described by Hutchinson, 28" below road surface. Directly over found drag tooth, I set a 1 1/4" x 26" new black iron pipe with a 4" brass cap.

THOIS DT RTK GPS NAD83 (2001) ON BRASS CAP IN ROAD:

N 359408.66' E 619220.33' 1529.3

ADDED TIES PK IN N. FACE P. POLE EAST 34.42


11" E FACE " SOUTH 43.00

FB 3-89

- (c) In the plan view drawing below, provide reference ties to at least 4 witness monuments, or, if the location is within a municipality, to at least 2 witness monuments. (Witness monuments shall be made of concrete, natural stone, iron or other equally durable material.) Describe witness monuments.

- ⊙ = 3/4" x 30" re-bar set flush with ground.
- ⊥ = vinyl sign post set.
- ▼ = PK nail found

- (d) Show a plan view drawing depicting the relevant monuments and reference ties which is sufficient in detail to enable accurate relocation of the corner monument if the corner monument is disturbed. Indicate north.

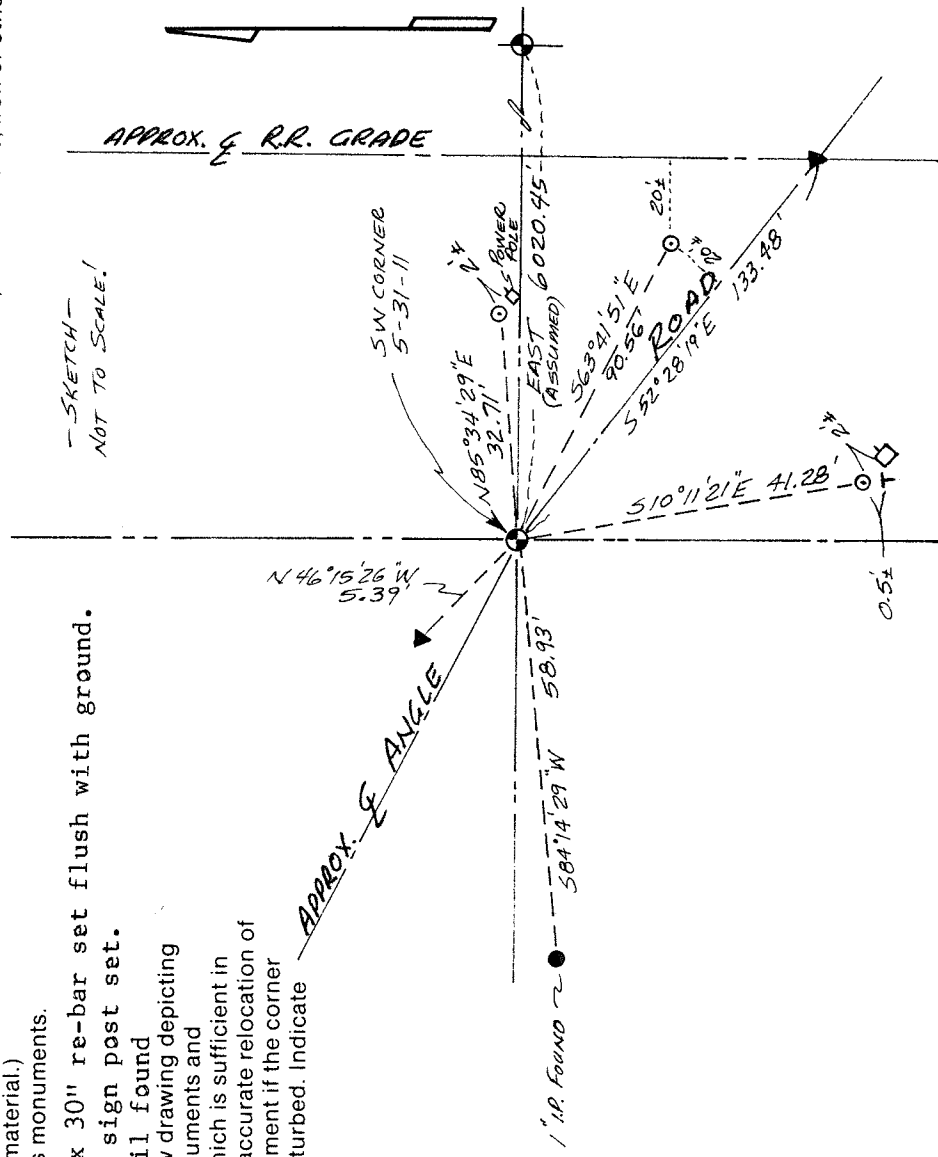

*- SKETCH -
 NOT TO SCALE!*

E5

FB 3-89

4311660000

Describe any material discrepancy between the location of the corner as restored or reestablished and the location of that corner as previously restored or reestablished by distance and direction. Show the discrepancy on the plan view drawing under (d), above. Show the distances between the corner as previously restored or reestablished and (1) the corner as restored or reestablished, and (2) to at least 2 of the witness monuments shown on the drawing in (d), above.

Former surveyor Kelly may have set the PK I found to the NW and may have used it as the corner.

(f) Was the corner restored through acceptance of (1) an obliterated evidence location, or, (2) a found perpetuated location?
A found perpetuated location.

(g & h) Was the corner reestablished through lost corner proportionate methods? If so, show the method, including the directions and distances to other public land survey corners used as evidence or used for proportioning in determining the corner location.
Nc.

(i) I, David E. Tlusty, Langlade County Surveyor,
(type or print name)

certify that the corner location shown on this record was determined by me or under my direction and control and that this U.S. Public Land Survey Monument Record is correct and complete to the best of my knowledge and belief.

David E. Tlusty 8/24/93
Signature Date

