

CERTIFIED LAND CORNER RESTORATION

Index No. Q-2

State of Wisconsin }
County of Langlade } ss.

I Raymond Hallisy, do hereby certify that on the 25th day of April, 1987, I found evidence of the SW 1/16 corner of Section 19 Township 31 North, Range 11E, Fourth Principal Meridian, as described hereon; and that from this evidence I established a new monument and accessories as described hereon to perpetuate the original location of this corner.

Resident witnesses:

History of original corner establishment:

CORNER set by county surveyor in EARLY 1900's

Description of corner evidence found:

CORNER WAS DESTROYED BY LAND CLEARING. TRANSIT LINE WAS RUN FROM SOUTH 1/8 COR TO WEST CENTER 1/16 COR AND CORNER SET AT ORIGINAL DISTANCE.

Description of monument and accessories I established to perpetuate the original location of this corner.

Set 2" pipe with Brass CAP


NO TREES FOR BT'S

Set 2' 1" DIA X

3' with 6" Flange

FORD TRUCK AXLE

FOR REFERENCE OF COR IN OLD FENCE LINE.

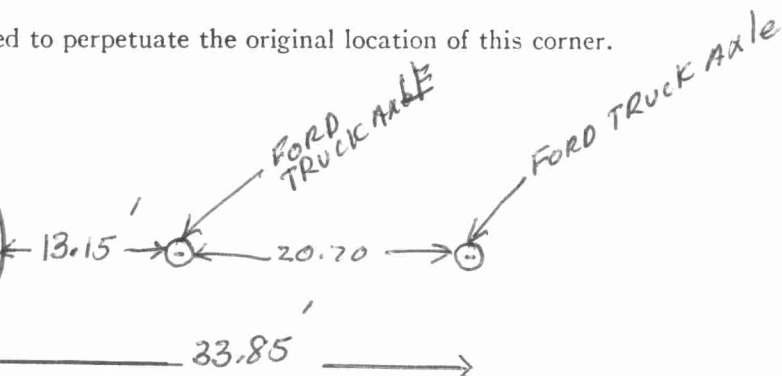

Dated at Antigo, Wis., this 25th day of April, 1987.


Signature: Raymond Hallisy Title: Land Surveyor Registration No. 5-685
(County Surveyor, Registered Land Surveyor, or other duly authorized official)

Office of Register of Deeds, County of _____, I hereby certify that the within instrument was filed in this office for record on the _____ day of _____, 19____ at _____ o'clock _____ M.

(Register of Deeds)

By _____ Deputy

FORM 985 H. C. MILLER CO., MILWAUKEE
43111191030

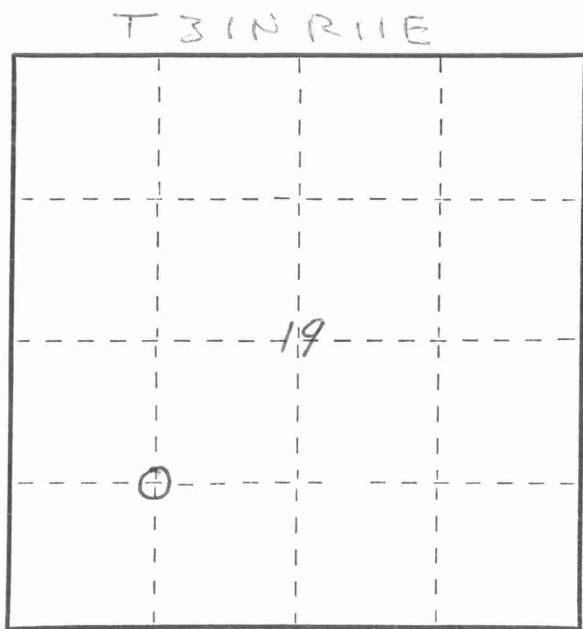

○ = Corner monument restored.

