

CERTIFIED LAND CORNER RESTORATION

Index No. R-9

State of Wisconsin }
County of Lanlade } ss.

History of original corner establishment:
Resurvey Notes

I Gary A. Radtke, do hereby certify that on the 10th day of April, 1978, I found evidence of the SW. 1/2 Corner corner of Section 21 Township 31, North, Range 11 East, Fourth Principal Meridian, as described hereon; and that from this evidence I established a new monument and accessories as described hereon to perpetuate the original location of this corner.


Description of corner evidence found: None

Resident witnesses:




Description of monument and accessories I established to perpetuate the original location of this corner.

Nails In Power Poles

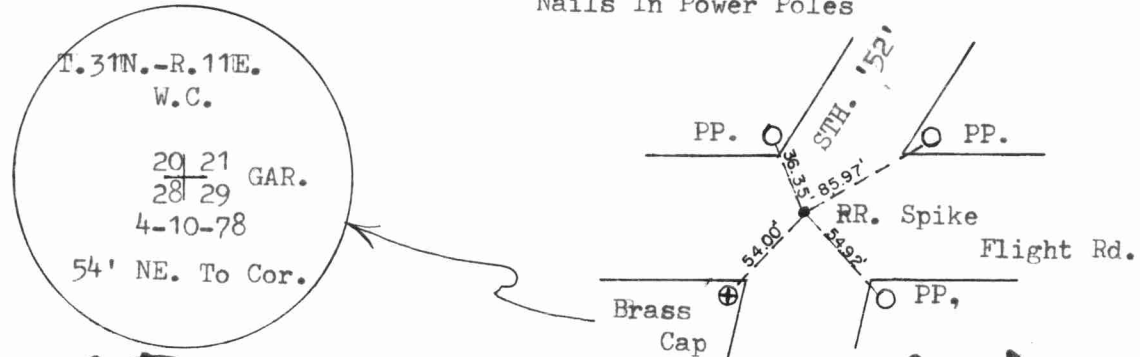

FORM 985 H. C. MILLER CO., MILWAUKEE

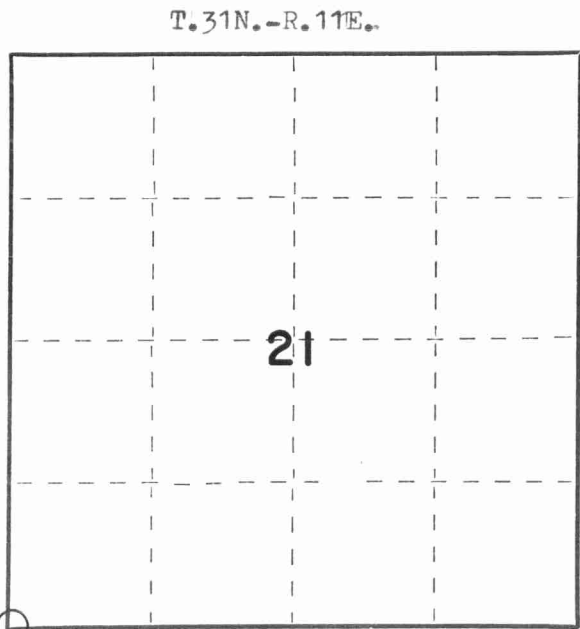

○ = Corner monument restored.

Dated at Antigo, Wis., this 19th day of April, 1978

Signature Gary Radtke Title RLS Registration No. S-1248
(County Surveyor, Registered Land Surveyor, or other duly authorized official)

Office of Register of Deeds, County of _____, I hereby certify that the within instrument was filed in this office for record on the _____ day of _____, 19____ at _____ o'clock _____ M.

(Register of Deeds)

By _____ Deputy

43111200000

