

U.S. PUBLIC LAND SURVEY MONUMENT RECORD

(Prepared and as required by S. A-E 7.08 WI Administrative Code)

The NORTHEAST corner of Section 29, T. 3/N., R. 11E., Langlade County, WI

Corner was: (check all that apply)

- Restored through acceptance of an obliterated evidence location.
- Restored through acceptance of a found perpetuated location.
- Determined to be lost and re-established through proportionate methods.
(Show bearings and distances to PLSS corners used for proportioning.)
- Restored/recovered/reestablished in a location that differs from a previously established position. (Show difference in plan view below.)

Check here if additional information is shown on the reverse side of this form.

Describe record evidence, recovered physical evidence, occupational evidence, testimonial evidence and all other evidence considered in the recovery/restoration of the corner.


The original corner was established in 1860 by Hiram C. Fellows. Original bearing trees: sugar, 12", N25°W, 7 links, and an elm, 8", S60°E, 10 links. Dorr used this corner in 1884, 1888 and 1898 but didn't describe it. In 1910, E.S. Brooks measured to this corner from the 1/4 corner to the west (2731') and described this corner as a stone in the road. In 1938, Malcolm Hutchinson set this corner "by measurement of Dorr's" and set drive point for corner. He tied the corner to the NE corner of house, S70°W, 1.87 chains (123.42'). In 1978, Gary Radtke found no evidence for the corner, but measured ties to a railroad spike set in the road. Since 1978, numerous surveys were tied to Radtke's railroad spike. In 1999, I find that Hutchinsons' house tie distance to Radtke's corner does not work; there is a very good chain of history up to 1938, and Radtke has no history or justification for the railroad spike he tied, therefore, I re-set this corner using Hutchinsons' bearing (corrected) & distance from the house corner.

Physical description of the monument set:

Set 4 1/2" x 1/2" gear headed spike for corner.

Describe the accessories used to perpetuate the location of the corner. Include a plan view drawing and indicate accessories found/set. Describe measuring point on bearing trees. Show any topographic features that would aid in future recovery of the corner.

10/15/04 A TRUSTY SET SN-1 NAIL w/REK GRS.

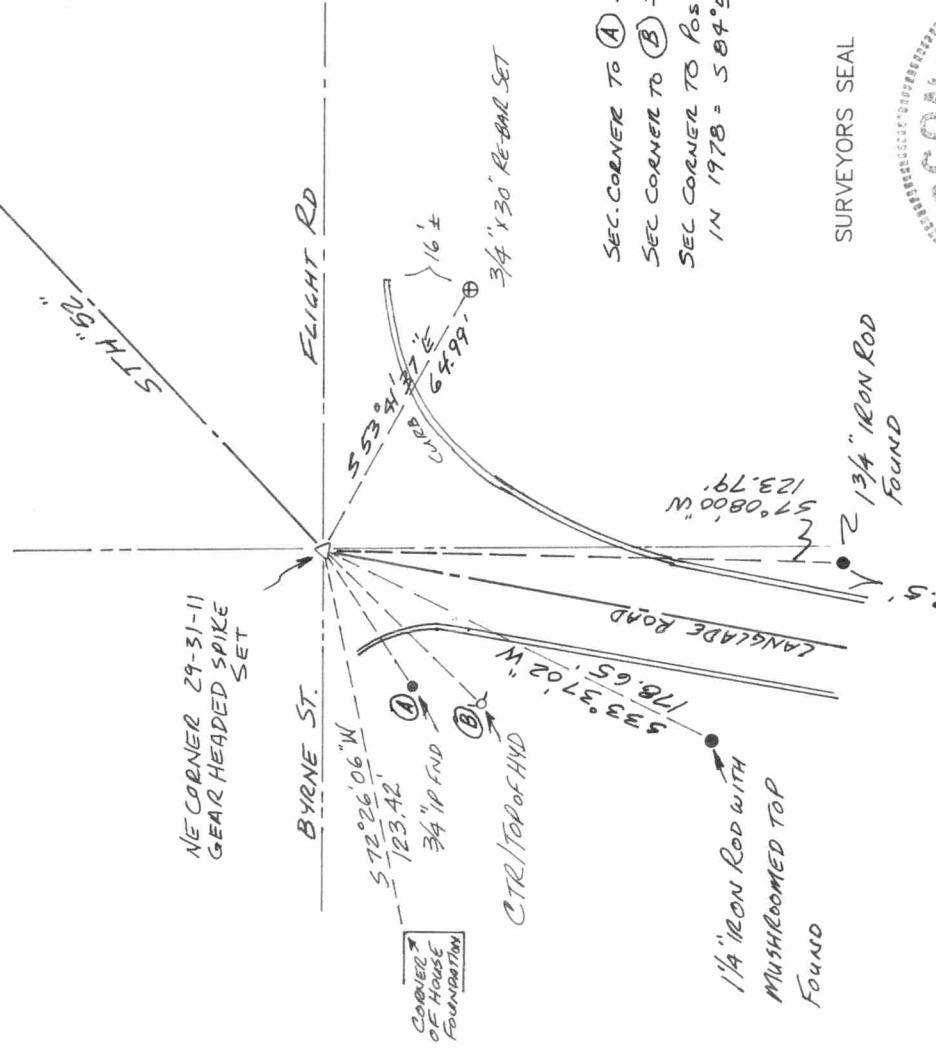

431130000

Note: A copy of the board-approved form is available from the Department of
Regulation and Licensing, Bureau of Business and Design Professions, 1400 East
Washington Avenue, P.O. Box 8935, Madison, Wisconsin 53708.

(3) MONUMENT RECORD REQUIREMENTS. A U.S. public land survey monument record shall show the location of the corner and shall include all of the following elements:

- (a) The identity of the corner, as referenced to the U.S. public land survey system;
- (b) A description of any record evidence, monument evidence, occupational evidence, testimonial evidence or any other material evidence considered by the surveyor, and whether the monument was found or placed;
- (c) Reference ties to at least 4 witness monuments. Witness monuments shall be concrete, natural stone, iron, bearing trees or other equally durable material, except wood other than bearing trees;

(d) A plan view drawing depicting the relevant monuments and reference ties which is sufficient in detail to enable accurate relocation of the corner monument if the corner monument is disturbed;

(e) A description of any material discrepancy between the location of the corner as restored or reestablished and the location of that corner as previously restored or reestablished;

(f) Whether the corner was restored through acceptance of an obliterated evidence location or a found perpetuated location;

(g) Whether the corner was reestablished through lost-corner-proportionate methods;

(h) The directions and distances to other public land survey corners which were used as evidence or used for proportioning in determining the corner location; and,

(i) The stamp and signature or seal and signature of the land surveyor under whose direction and control the corner location was determined and a statement certifying that the U.S. public land survey monument record is correct and complete to the best of his or her knowledge and belief.

History: Cr. Register February, 1987, No. 374, eff. 3-1-87; am. (1) and (3)(c)

Register, May, 1989, No. 401, eff. 6-1-89.

E1/4 corner, Sec. 20

3/4" iron rod found



N 0°50'42" E 2618.34' S 3°02'41" W 1339.61'

Distr, 1888, 1330.56' Distr, 1884, 2673.16'

S 3°09'46" W 2683.09' Distr, date unknown, 2683.56'

N1/4 corner, Sec. 29
Iron pipe w/cap found

N 86°28'49" W 2732.54'
Brooks, 1910, 2731'

NE corner, Sec. 29
Set gear headed spike.

E1/4 corner
N 1/16 corner
2" ip found

E1/4 corner, Sec. 29
1" ip by Tom Arnott