

U.S. PUBLIC LAND SURVEY MONUMENT RECORD

(Prepared and as required by S. A-E 7.08 WI Administrative Code)

The EAST 1/4 corner of Section 20, T. 31 N., R. 11 E., Langlade County, WI
 Corner was (check all that apply)

- Restored through acceptance of an obliterated evidence location.
- Restored through acceptance of a found perpetuated location.
- Determined to be lost and re-established through proportionate methods. (show bearings and distances to PLSS corners used for proportioning.)
- Restored/recovered/re-established in a location that differs from a previously established position. (Show difference in plan view below.)
- Check here if additional information is shown on the reverse side of this form.

Describe record evidence, recovered physical evidence, occupational evidence, testimonial evidence, and all other evidence considered in the recovery/restoration of the corner.

1860 - Original corner established by H.C. Fellows - bearing trees: Sugar, 12", S88°W, 20 links; Fir, 8", S44°E, 12 links.


1985 - Edwin Abendroth "found pk nail over iron pipe. Ran EDM traverse around 1/4 Section corner fit protracted distances and interior fences." Abendroth made ties and filed a tie sheet.

2023 - I found an existing gin spike at the corner location. Location matches existing ties and survey work in the area.

Physical description of the monument set:

Accepted gin spike as corner location and tied out as shown below.

Describe the accessories used to perpetuate the location of the corner. Include a plan view drawing and indicate accessories found/set. Describe measuring point on bearing trees. Show any topographic features that would aid in future recovery of the corner.

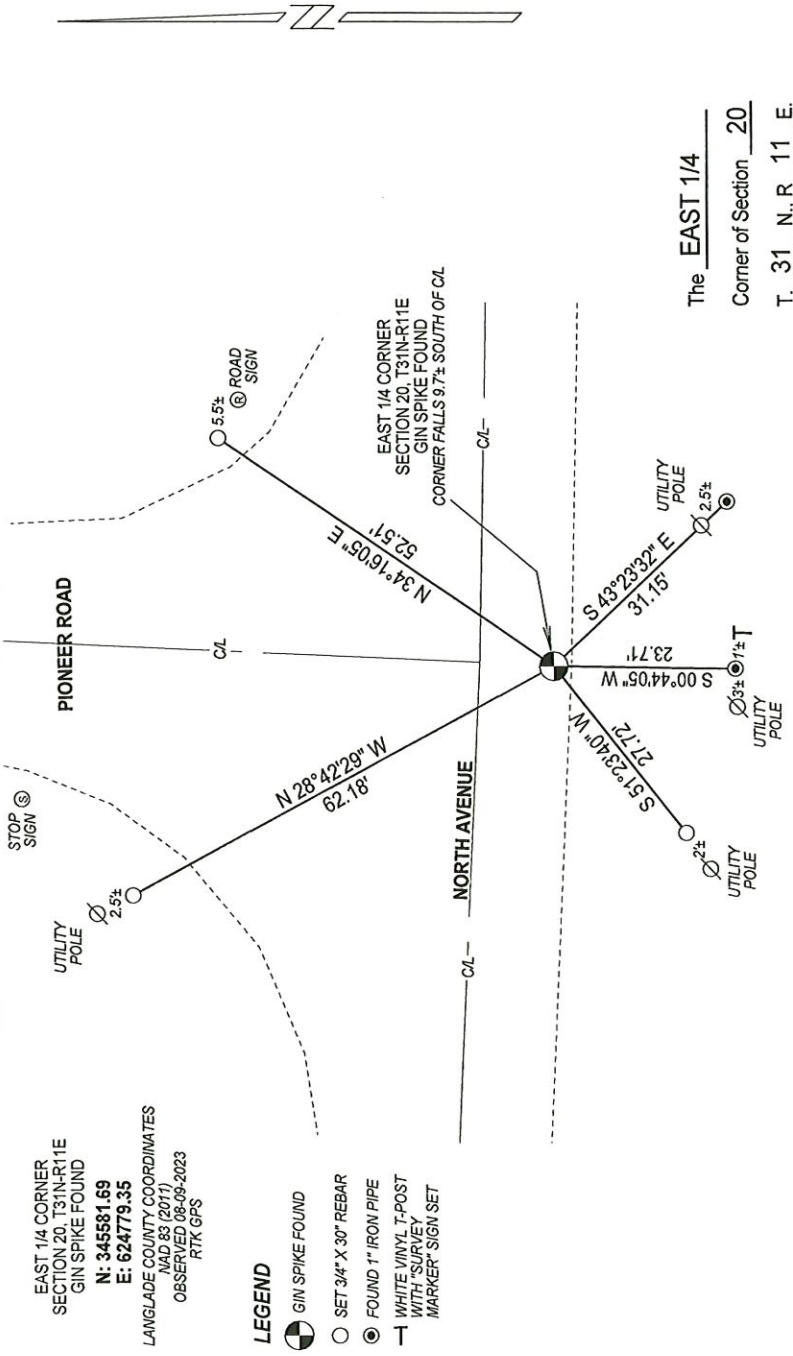


EAST 1/4 CORNER
 SECTION 20, T31N-R11E
 GIN SPIKE FOUND
 N: 345581.69
 E: 624779.35
 LANGLADE COUNTY COORDINATES
 (NAD 83 (2011))
 OBSERVED 08-09-2023
 RTK GPS

LEGEND

- GIN SPIKE FOUND
- SET 3/4" X 30" REBAR
- FOUND 1" IRON PIPE
- WHITE VINYL T-POST WITH SURVEY MARKER SIGN SET

The EAST 1/4
 Corner of Section 20
 T. 31 N., R. 11 E.
 Langlade County, WI

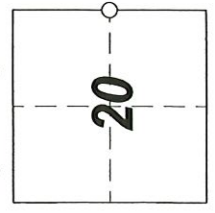

INDEX No. **P - 9** 4311120 2000

SURVEYORS SEAL



I, Michael J. Hoffman certify that the corner location shown on this record was determined by me or under my direction and control and that this U.S. Public Land Survey Monument Record is correct and complete to the best of my knowledge and belief.

Michael Hoffman 09-27-2023
 Signature Date

○ = Location of corner

NOTES
 - SKETCH NOT DRAWN TO SCALE.
 - TIE BEARINGS SHOWN ARE LANGLADE COUNTY GRID BEARINGS.
 - ALL TIES MEASURED ELECTRONICALLY WITH TOTAL STATION.

4311802000


U. S. PUBLIC LAND SURVEY MONUMENT RECORD

INSTRUCTIONS:

This record shall show the location of the corner and shall include all of the following nine elements (a through i).

- (a) Identify the corner by reference to the U.S. public land survey system.
- O = Corner monument restored.

West $\frac{1}{4}$ corner of Section 21, T31N, R11E, Town of Antigo.

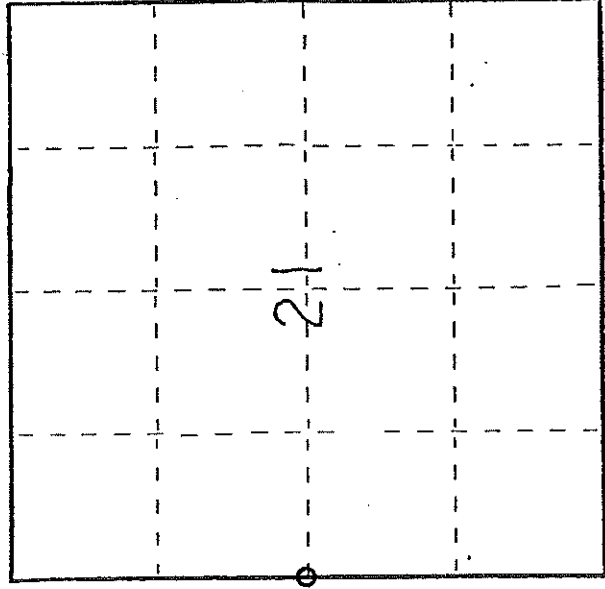


T 3 1 N R 1 1 E

- (b) Describe any record evidence, monument evidence, occupational evidence, testimonial evidence or any other material evidence you considered, and whether the monument was found or placed.

Found PK nail over iron pipe. Ran EDM traverse around $\frac{1}{4}$ Section corner fit protracted distances and interior fences.

- (c) In the plan view drawing below, provide reference ties to at least 4 witness monuments, or, if the location is within a municipality, to at least 2 witness monuments. (Witness monuments shall be made of concrete, natural stone, iron or other equally durable material.) Describe witness monuments.

Bearings reference to Magnetic North.

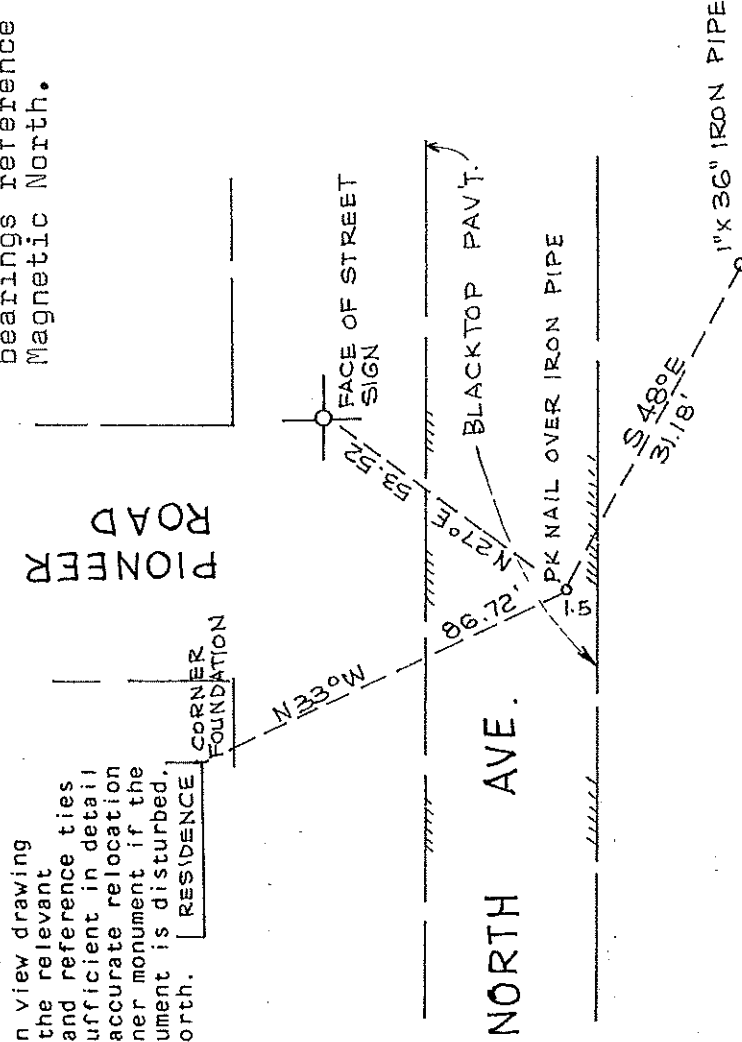

(e) Describe any material discrepancy between the location of the corner as restored or reestablished and the location of that corner as previously restored or reestablished by distance and direction. Show the discrepancy on the plan view drawing under (d), above. Show the distances between the corner as previously restored or reestablished and (1) the corner as restored or reestablished, and (2) to at least 2 of the witness monuments shown on the drawing in (d), above.

No known material discrepancy.

4311202000

(f) Was the corner restored through acceptance of (1) an obliterated evidence location, or, (2) a found perpetuated location?

(2)

(g&h) Was the corner reestablished through lost corner proportionate methods? If so, show the method, including the directions and distances to other public land survey corners used as evidence or used for proportioning in determining the corner location?

No.

(i) I, Edwin R. Abendroth
(Type or print name) certify that the corner location shown on this record was determined by me or under my direction and control and that this U.S. Public Land Survey Monument Record is correct and complete to the best of my knowledge and belief.

Edwin R. Abendroth 7-18-85
Signature Date

