

CERTIFIED LAND CORNER RESTORATION

31-11
Index No. P-17



State of Wisconsin }
County of LANGLADE } ss.

I ROBERT J. POSS, do hereby certify that on the 3RD day of JUNE, 1970, I found evidence of the 1/4 Sec. corner of Secs 22 & 23 Township 31, North, Range 11 EAST, Fourth, Principal Meridian, as described hereon; and that from this evidence I established a new monument and accessories as described hereon to perpetuate the original location of this corner.

History of original corner establishment:

Description of corner evidence found:

BOTH WITNESSES ALLEGE THAT THE FENCES HAVE ALWAYS BEEN LINE FENCES - AND WERE IN PLACE OVER 40 YRS.


Resident witnesses:

CHARLES MARMES (75 - LIFELONG RES.)

ANTON KUENZLI (40 YR. RESIDENT.)

Description of monument and accessories I established to perpetuate the original location of this corner.


SET 1/4" IRON PIPE PAINTED ORANGE W/BRASS CAP MKD

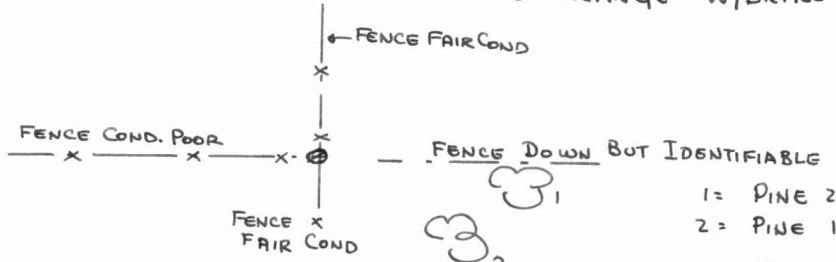

1/4 COR
SEC. 22 SEC. 23
T 31 N R 11 E.

- 1 = PINE 24 S 82 1/2 E 65.0
- 2 = PINE 16 S 66 1/2 E 71.2

TREES NOT BLAZED OR SCRIBED.

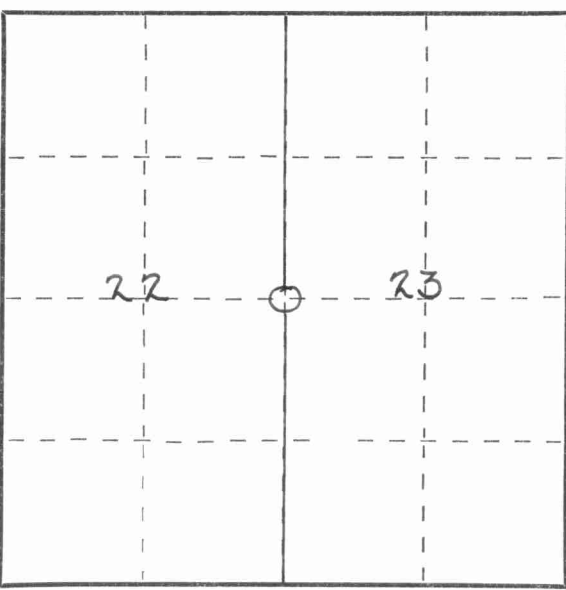

○ = Corner monument restored.

Dated at ELCHO, Wis., this 3RD day of JUNE, 1970.

Signature Robert J. Poss Title REG. LAND SURVEYOR Registration No. S-0001
(County Surveyor, Registered Land Surveyor, or other duly authorized official)

Office of Register of Deeds, County of _____, I hereby certify that the within instrument was filed in this office for record on the _____ day of _____, 19____ at _____ o'clock _____ M.

(Register of Deeds)

By _____ Deputy

FORM 985 R. C. MILLER CO., MILWAUKEE 4311222000

