

CERTIFIED LAND CORNER RESTORATION

31-1
Index No. 0-17

State of Wisconsin }
County of LANGLADE } ss.

I ROBERT J. POSS, do hereby certify that on the 3RD day of JUNE, 1970, I found evidence of the NORTH 1/16 corner of SECS. 22 & 23 Township 31, North, Range 11 EAST, Fourth, Principal Meridian, as described hereon; and that from this evidence I established a new monument and accessories as described hereon to perpetuate the original location of this corner.

Resident witnesses:


CHARLES MARMES (75 - LIFELONG RES.)
ANTON KUENZLI (40 YR. RESIDENT)

History of original corner establishment:

Description of corner evidence found:

FOUND TWO FENCE LINES (N&S) - ONE HAD BEEN W. LINE OF TOWN ROAD NOW ABANDONED - NEWER FENCE 24.5' EAST MARKING THE SEC. LINE BOTH WITNESSES. ALLEGED THE FENCES ARE OVER 40 YRS. OLD AND HAVE BEEN LINE FENCES.

Description of monument and accessories I established to perpetuate the original location of this corner.

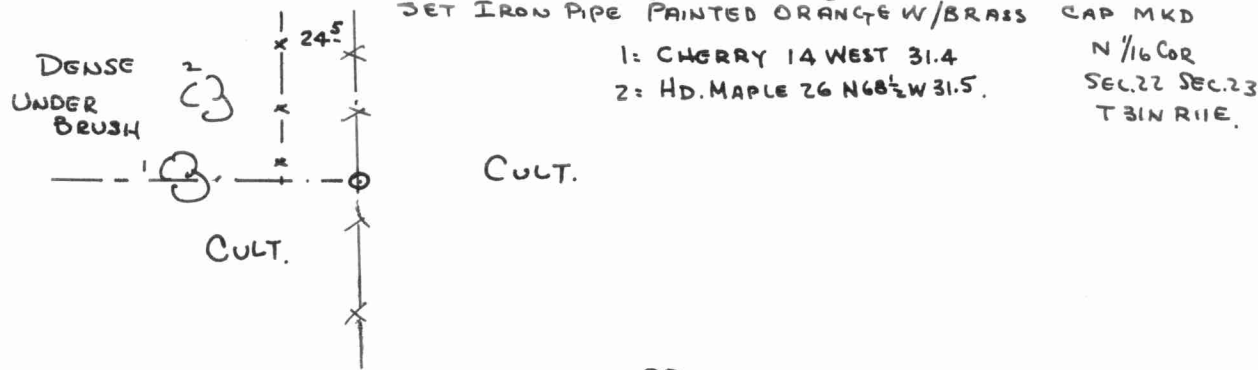


Dated at ELGIN, Wis., this 3RD day of JUNE, 1970.

Signature Robert J. Poss Title REG. LAND SURVEYOR Registration No. S-0001
(County Surveyor, Registered Land Surveyor, or other duly authorized official)

Office of Register of Deeds, County of _____, I hereby certify that the within instrument was filed in this office for record on the _____ day of _____, 19____ at _____ o'clock _____ M.

(Register of Deeds)

By _____ Deputy

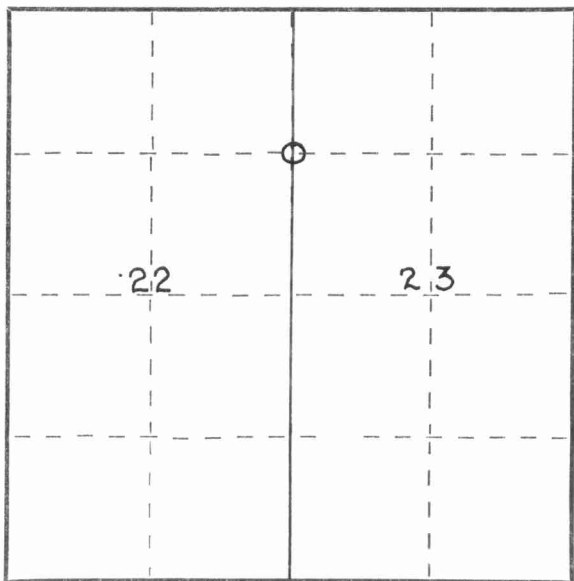

○ = Corner monument restored.

FORM 985 H. C. MILLER CO., MILWAUKEE 43111223000

