

CERTIFIED LAND CORNER RESTORATION

31-11 Index No. V-18

State of Wisconsin }  
County of LANGLADE } ss.

I ROBERT J. POSS, do hereby certify that on the 10<sup>TH</sup> day of JUNE, 19 70, I found evidence of the W 1/16 corner of SECS. 26 & 35 Township 31, North, Range 11 EAST, Fourth, Principal Meridian, as described hereon; and that from this evidence I established a new monument and accessories as described hereon to perpetuate the original location of this corner.

Resident witnesses:

GEORGE SCHMIDT

History of original corner establishment:


Description of corner evidence found:

FOUND IRON PIPE - SCHMIDT SAYS HE MOVED PIPE ACCT. IN WHEEL TRACK - PIPE IS 1.65' SO. OF COR. LEFT PIPE IN PLACE.



Description of monument and accessories I established to perpetuate the original location of this corner.

SET 1/4" PIPE-IRON - PAINTED ORANGE W/BRASS CAP MKD HD MAPLE 38 N 83 E 42.0 W 1/16 COR SEC. 26-35 T31N R11E

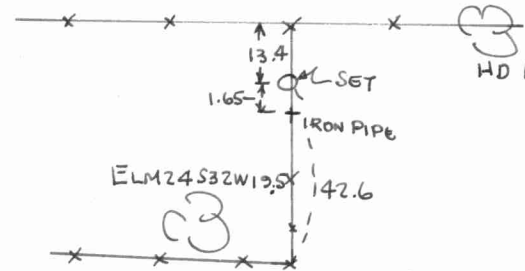

DID NOT BLAZE TREES


Dated at ELCHO, Wis., this 19<sup>TH</sup> day of JUNE, 19 70.

Signature Robert J. Poss Title REG. LAND SURVEYOR Registration No. S-0001  
(County Surveyor, Registered Land Surveyor, or other duly authorized official)

Office of Register of Deeds, County of \_\_\_\_\_, I hereby certify that the within instrument was filed in this office for record on the \_\_\_\_\_ day of \_\_\_\_\_, 19 \_\_\_\_\_ at \_\_\_\_\_ o'clock \_\_\_\_\_ M.

(Register of Deeds)

By \_\_\_\_\_ Deputy

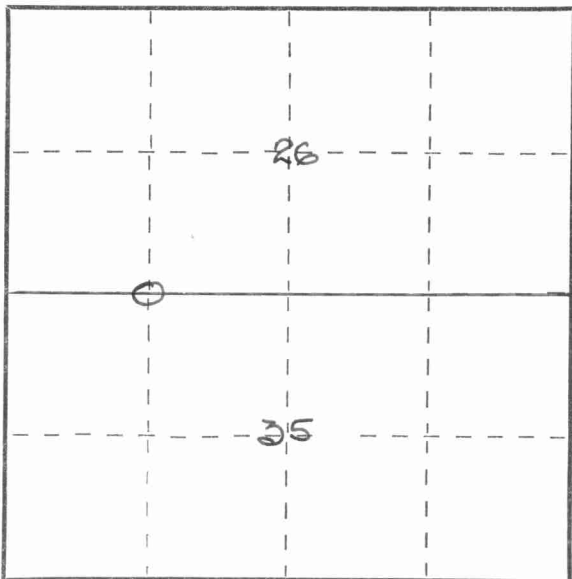

○ = Corner monument restored.

FORM 985 H. C. MILLER CO., MILWAUKEE

4311260030

