

CERTIFIED LAND CORNER RESTORATION

31-11

Index No. W-17

State of Wisconsin }  
County of LANGLADE } ss.

I ROBERT J. POSS, do hereby certify that on the 10TH day of JUNE, 1970, I found evidence of the N 1/4 corner of SECS. 34 & 35 Township 31, North, Range 11 EAST, Fourth, Principal Meridian, as described hereon; and that from this evidence I established a new monument and accessories as described hereon to perpetuate the original location of this corner.

History of original corner establishment:



Description of corner evidence found:


FOUND IRON PIPE - PROBABLY BY HUTCHINSON AT JCN. OF LINE FENCES.

Resident witnesses:

GEORGE SCHMIOT

Description of monument and accessories I established to perpetuate the original location of this corner.

SET 1 1/4" IRON PIPE W/BRASS CAP MK N 1/4  
POST IS 1.5' SO OF FENCE JCN.  
SEC. 34 SEC. 35  
T 31 N R 11 E

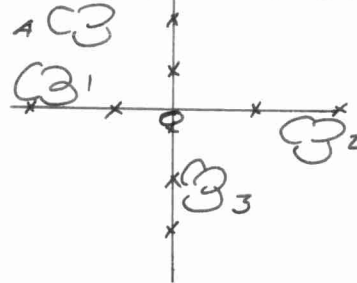

- 1 = Hd. Maple 20 N 87 1/2 W 34.5
  - 2 = Hd. Maple 16 EAST 12.0
  - 3 = Hd. Maple 30 S 2° E 44.0
  - A = OLD BLAZE ON MAPLE N 60 W 15.5
- All trees blazed  
no scribe


Dated at ELCHO, Wis., this 19TH day of JUNE, 1970.

Signature Robert J. Poss Title REG. LAND SURVEYOR Registration No. S-0001  
(County Surveyor, Registered Land Surveyor, or other duly authorized official)

Office of Register of Deeds, County of \_\_\_\_\_, I hereby certify that the within instrument was filed in this office for record on the \_\_\_\_\_ day of \_\_\_\_\_, 19\_\_\_\_ at \_\_\_\_\_ o'clock \_\_\_\_\_ M.

(Register of Deeds)

By \_\_\_\_\_ Deputy

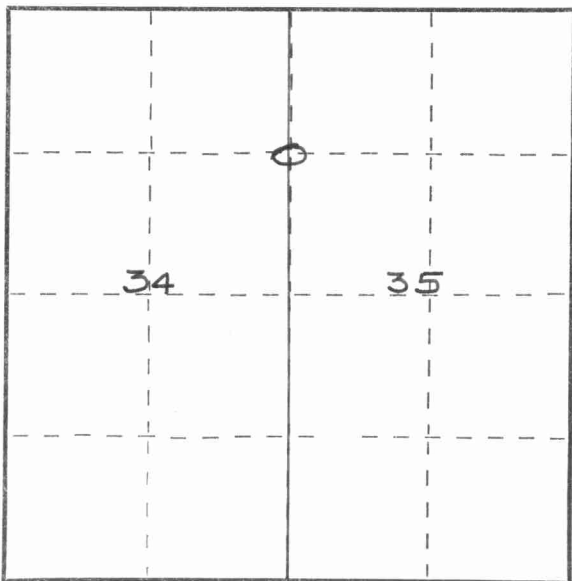

○ = Corner monument restored.

FORM 985 H. C. MILLER CO., MILWAUKEE  
43111343000

