

CERTIFIED LAND CORNER RESTORATION

31-11 Index No. Y-19

State of Wisconsin }  
County of LANGLADE } ss.

I ROBERT J. POSS, do hereby certify that on the 5<sup>TH</sup> day of JUNE, 1970, I found evidence of the SOUTH CTR. 1/16 corner of SEC. 35 Township 31, North, Range 11 EAST, Fourth, Principal Meridian, as described hereon; and that from this evidence I established a new monument and accessories as described hereon to perpetuate the original location of this corner.

Resident witnesses:

WILEY PETROSKEY (RES. 35 YRS.)

History of original corner establishment:


Description of corner evidence found:

FOUND PCS. OF OLD POST BETWEEN 2 FENCE POSTS. FENCES OFFSET




Description of monument and accessories I established to perpetuate the original location of this corner.

SET 1/4" IRON PIPE PAINTED ORANGE W/BRASS CAP MKD.

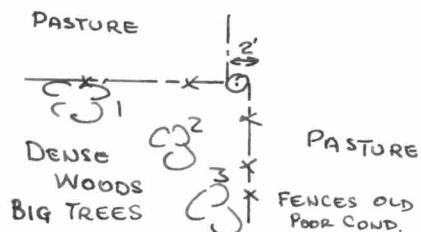

- 1. HD. MAPLE 16 N88W 35.5
  - 2. HD. MAPLE 12 S21 1/2 W 13.0
  - 3. BASSWOOD 14 S5W 33.6.
- ALL TREES BLAZED & SCRIBED NBT

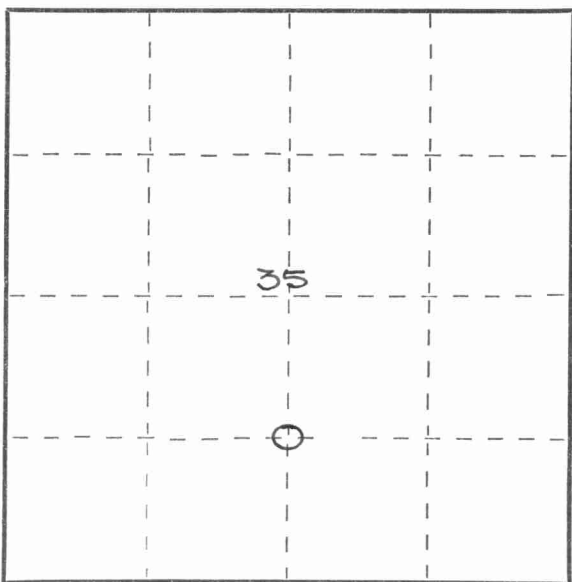

○ = Corner monument restored.

Dated at ELCHO, Wis., this 5<sup>TH</sup> day of JUNE, 1970.

Signature Robert J. Poss Title REG. LAND SURVEYOR Registration No. S-0001  
(County Surveyor, Registered Land Surveyor, or other duly authorized official)

Office of Register of Deeds, County of \_\_\_\_\_, I hereby certify that the within instrument was filed in this office for record on the \_\_\_\_\_ day of \_\_\_\_\_, 19\_\_\_\_ at \_\_\_\_\_ o'clock \_\_\_\_\_ M.

(Register of Deeds)

By \_\_\_\_\_ Deputy

FORM 985 H. C. MILLER CO., MILWAUKEE

43111351029

