

CERTIFIED LAND CORNER RESTORATION

31-11 Index No. W-18



State of Wisconsin }
County of LANGLADE } ss.

I ROBERT J. POSS, do hereby certify that on the 10TH day of JUNE, 1970, I found evidence of the N.W. 1/4 corner of SEC. 35 Township 31, North, Range 11 EAST Fourth, Principal Meridian, as described hereon; and that from this evidence I established a new monument and accessories as described hereon to perpetuate the original location of this corner.

History of original corner establishment:

Description of corner evidence found:


FOUND 1" IRON PIPE 3 1/2 FT. EAST of FENCE CORNER. REFERENCE MADE IN HUTCHINSON'S NOTES

Resident witnesses:

GEORGE SCHMIDT


Description of monument and accessories I established to perpetuate the original location of this corner.

SET 1/4-INCH PIPE W/BRASS CAP - PAINTED ORANGE PUT ROCKS AROUND POST

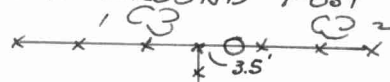

- 1 = Y. BIRCH 24 N18 1/2 W13.3
 - 2 = HD. MAPLE 18 N38 1/2 E 23.4
 - 3 = HD. MAPLE 16 S9E 4.2
- ALL TREES BLAZED & SCRIBED NBT

MK. NW 1/4 SEC. 35 T31N R11E.

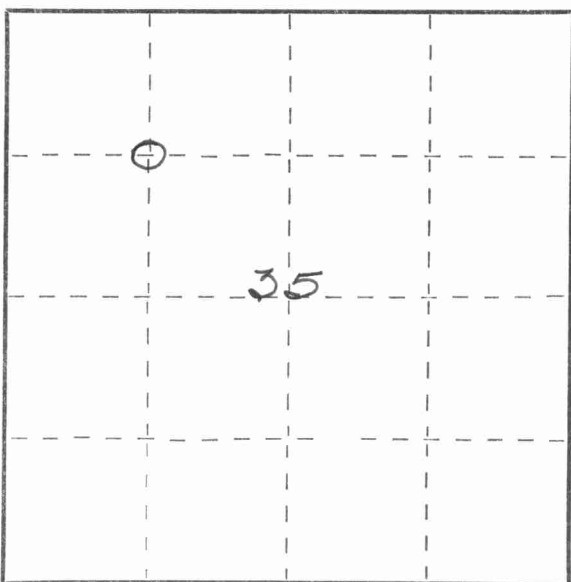

Dated at ELCHO, Wis., this 19TH day of JUNE, 1970.

Signature Robert J. Poss Title REG. LAND SURVEYOR Registration No. S-0001
(County Surveyor, Registered Land Surveyor, or other duly authorized official)

Office of Register of Deeds, County of _____, I hereby certify that the within instrument was filed in this office for record on the _____ day of _____, 19____ at _____ o'clock _____ M.

(Register of Deeds)

By _____ Deputy

○ = Corner monument restored.

FORM 985 R. C. MILLER CO., MILWAUKEE 43111353030

