

CERTIFIED LAND CORNER RESTORATION

Index No. C-25

31-12

State of Wisconsin }
 County of Langlade } ss.

I Raymond J. Hallisy, do hereby certify that on the 15th day of April, 1979, I found evidence of the 1/4 corner of Section 1 & 6 Township 31, North, Range 12E & 13E, Fourth Principal Meridian, as described hereon; and that from this evidence I established a new monument and accessories as described hereon to perpetuate the original location of this corner.

Resident witnesses:

.....

History of original corner establishment:


Description of corner evidence found:

Found Hutchinson's scribed stake in fence line that runs east and west. Stake marked 6, 1, 1/4S, rotten stumps of his BT's.

Description of monument and accessories I established to perpetuate the original location of this corner.

Set 2" pipe with brass cap.
 New BT's

- 6" Hard Maple S47E 13.6 Links
- 7" Hard Maple S81W 25.3 "
- 8" Hard Maple N38E 9.4 "

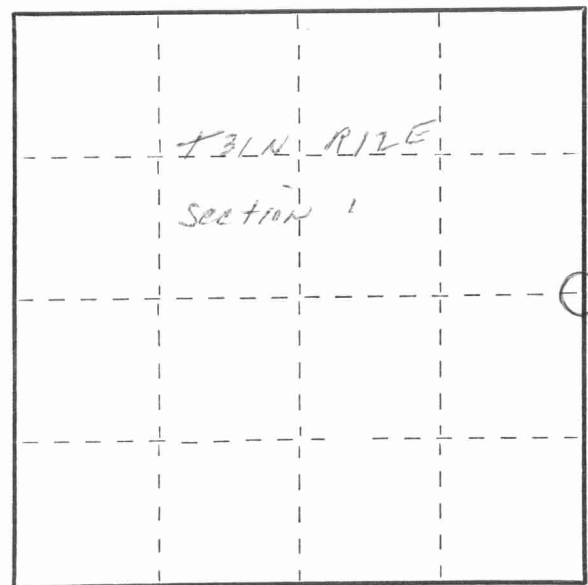

○ = Corner monument restored.

Dated at Antigo, Wis., this 15th day of April, 1979

Signature Raymond J. Hallisy Title Reg. Surveyor Registration No. S685
 (County Surveyor, Registered Land Surveyor, or other duly authorized official)

Office of Register of Deeds, County of _____, I hereby certify that the within instrument was filed in this office for record on the _____ day of _____, 19____ at _____ o'clock _____ M.

.....
 (Register of Deeds)

By _____ Deputy

FORM 985 H. C. MILLER CO., MILWAUKEE

