

# U.S. PUBLIC LAND SURVEY MONUMENT RECORD

(Prepared and as required by S. A-E 7.08 WI Administrative Code)

The SOUTH 1/4 corner of Section 2, T. 31 N., R. 12 E., Langlade County, WI  
Corner was (check all that apply)

- Restored through acceptance of an obliterated evidence location.
- Restored through acceptance of a found perpetuated location.
- Determined to be lost and re-established through proportionate methods. (show bearings and distances to PLSS corners used for proportioning.)
- Restored/recovered/re-established in a location that differs from a previously established position. (Show difference in plan view below.)
- Check here if additional information is shown on the reverse side of this form.


**Describe record evidence, recovered physical evidence, occupational evidence, testimonial evidence, and all other evidence considered in the recovery/restoration of the corner.**

1857 - Original corner established by J. McBride - bearing trees: Birch, 8", N10°W, 18 links and a Sugar, 8", S48°E, 4 links.  
 1914 - Fieldbook 94 Page 123, Brooks notes "one original BT down but plainly marked". New BT 13" Sugar, S55°30'E, 40.75 links.  
 1936 - Fieldbook 142 Page 42, Hutchinson notes corner as "iron pipe in road."  
 1981 - William Kelly "located axel called for in Co. Surveyor notes. Kelly set witness monument and made ties to corner and filed tie sheet.  
 2023 - I found a railroad spike 3" below the road surface in good condition. I verified corner location from existing witness monument set by Kelly and made additional ties.

**Physical description of the monument set:**

Accepted railroad spike as corner location and tied out as shown below.

Describe the accessories used to perpetuate the location of the corner. Include a plan view drawing and indicate accessories found/set. Describe measuring point on bearing trees. Show any topographic features that would aid in future recovery of the corner.

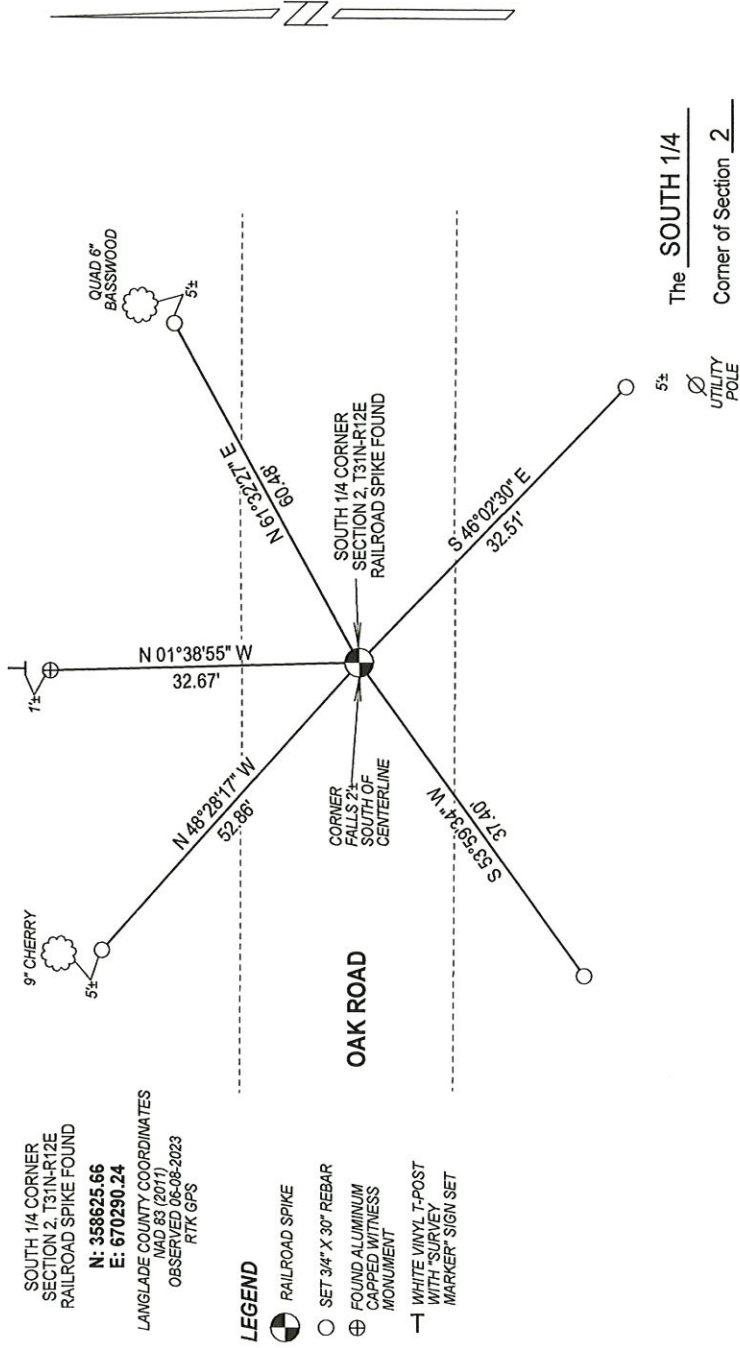


NOTES  
 - SKETCH NOT DRAWN TO SCALE.  
 - TIE BEARINGS SHOWN ARE LANGLADE COUNTY GRID BEARINGS.  
 - ALL TIES MEASURED ELECTRONICALLY WITH TOTAL STATION.

SURVEYORS SEAL




I, Michael J. Hoffman certify that the corner location shown on this record was determined by me or under my direction and control and that this U.S. Public Land Survey Monument Record is correct and complete to the best of my knowledge and belief.

Michael Hoffman Signature  
08-23-2023 Date

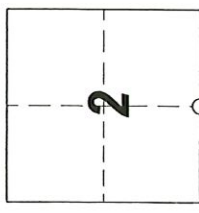

○ = Location of corner

 


Stock No. 26273

# U. S. PUBLIC LAND SURVEY MONUMENT RECORD

include all of the following nine elements (a through i).

LANGLADE COUNTY

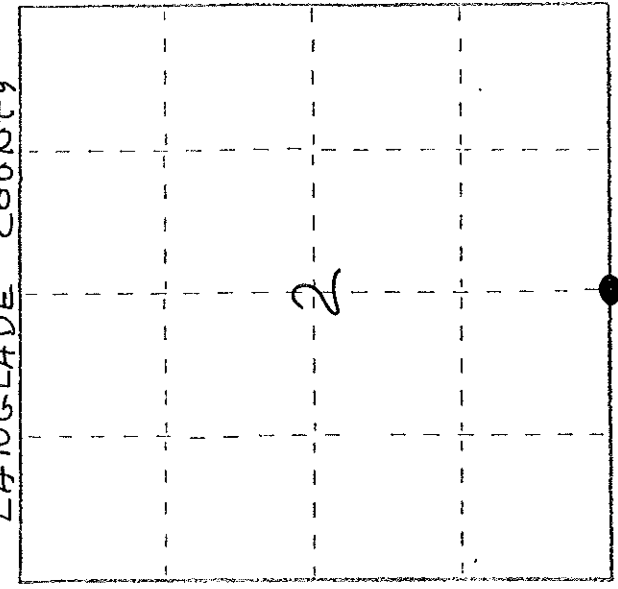

T 31 N R 12 E

- (a) Identify the corner by reference to the U.S. public land survey system.
- O = Corner monument restored.


ORIGINAL CORNER ESTABLISHED BY JAMES MC BRIDE - NOV DEC 1857

CORNER PERPETUATED BY M. HUTCHINSON IN 1930'S

- (b) Describe any record evidence, monument evidence, monument evidence, occupational evidence, testimonial evidence or any other material evidence you considered, and whether the monument was found or placed.

LOCATED AXEL CALLED FOR AN CO SURVEYOR NOTES. SET WITNESS MONUMENT AND MARKED WITNESS TREES

- (c) In the plan view drawing below, provide reference ties to at least 4 witness monuments, or, if the location is within a municipality, to at least 2 witness monuments. (Witness monuments shall be made of concrete, natural stone, iron or other equally durable material.) Describe witness monuments.

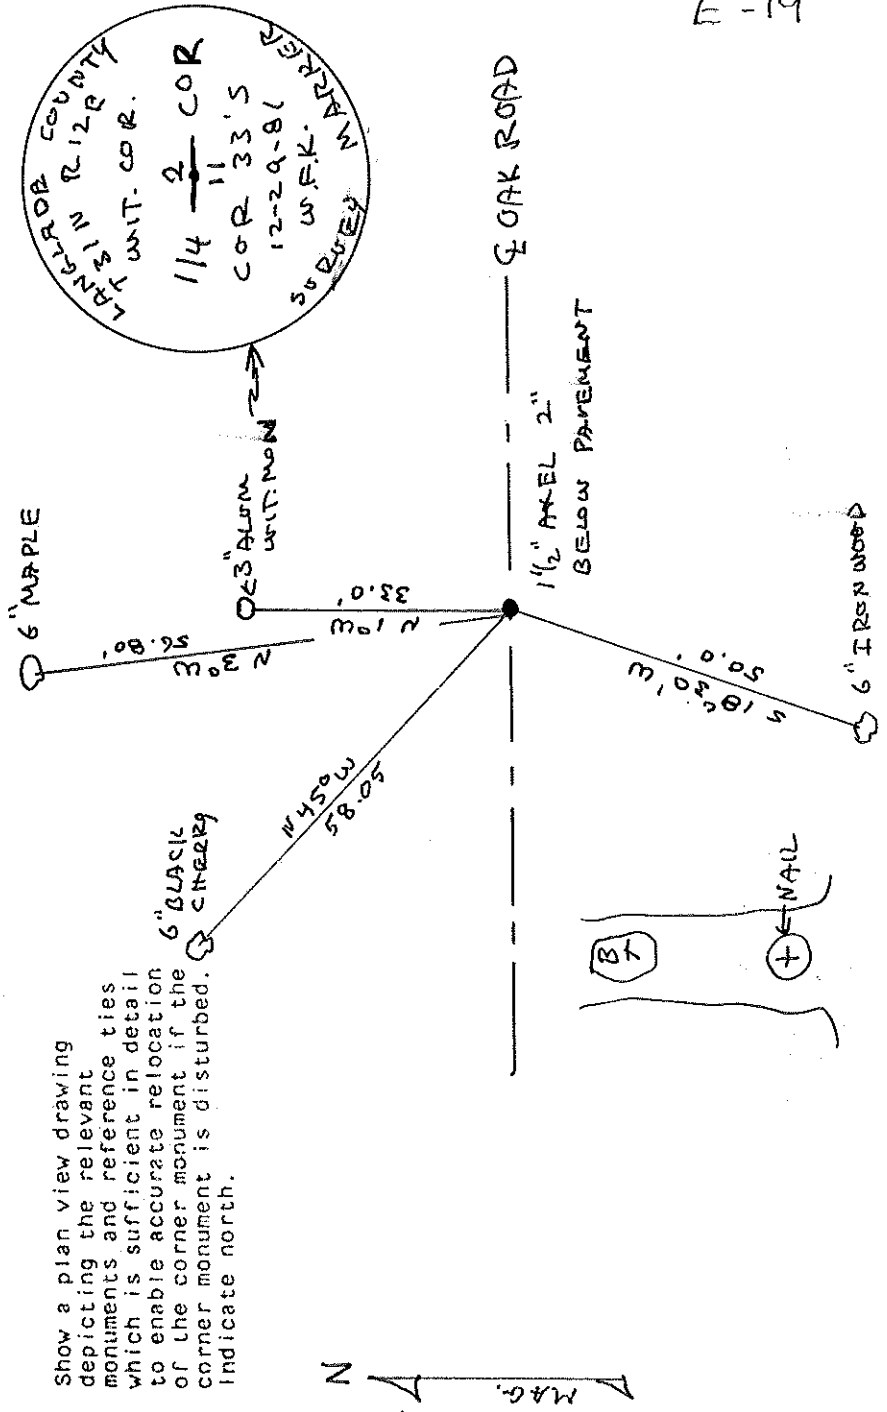

(e) Describe any material discrepancy between the location of the corner as restored or reestablished and the location of that corner as previously restored or reestablished by distance and direction. Show the discrepancy on the plan view drawing under (d), above. Show the distances between the corner as previously restored or reestablished and (1) the corner as restored or reestablished, and (2) to at least 2 of the witness monuments shown on the drawing in (d), above.

NONE

(f) Was the corner restored through acceptance of (1) an obliterated evidence location, or, (2) a found perpetuated location?

(2)

(g&h) Was the corner reestablished through lost corner proportionate methods? If so, show the method, including the directions and distances to other public land survey corners used as evidence or used for proportioning in determining the corner location?

NO

(1) WILLIAM F. KELLY

(Type or print name) certify that the corner location shown on this record was determined by me or under my direction and control and that this U.S. Public Land Survey Monument Record is correct and complete to the best of my knowledge and belief.

William F. Kelly  
Signature

12-30-87  
Date

