

# U.S. PUBLIC LAND SURVEY MONUMENT RECORD

(Prepared and as required by S. A-E 7.08 WI Administrative Code)

The EAST 1/4 corner of Section 3, T. 31 N., R. 12 E., Langlade County, WI  
Corner was (check all that apply)

- Restored through acceptance of an obliterated evidence location.
- Restored through acceptance of a found perpetuated location.
- Determined to be lost and re-established through proportionate methods. (show bearings and distances to PLSS corners used for proportioning.)
- Restored/recovered/re-established in a location that differs from a previously established position. (Show difference in plan view below.)
- Check here if additional information is shown on the reverse side of this form.

**Describe record evidence, recovered physical evidence, occupational evidence, testimonial evidence, and all other evidence considered in the recovery/restoration of the corner.**

1857 - Original corner established by J. McBride - bearing trees: Sugar, 18", S75°E, 12 links; Elm, 6", S60°W, 17 links.


1987 - William Kelly established corner on "straight line between the SW Corner and NW Corner of Section 2 and the intersection of E-W fence identified as '1/4 line", made ties to corner and filed tie sheet.

2023 - I found a railroad spike 5" below the road surface at the corner location. I verified corner location from existing witness monuments set by Kelly and made additional ties.

## Physical description of the monument set:

Accepted railroad spike found 5" below road surface as corner location and tied out as shown below.

Describe the accessories used to perpetuate the location of the corner. Include a plan view drawing and indicate accessories found/set. Describe measuring point on bearing trees. Show any topographic features that would aid in future recovery of the corner.

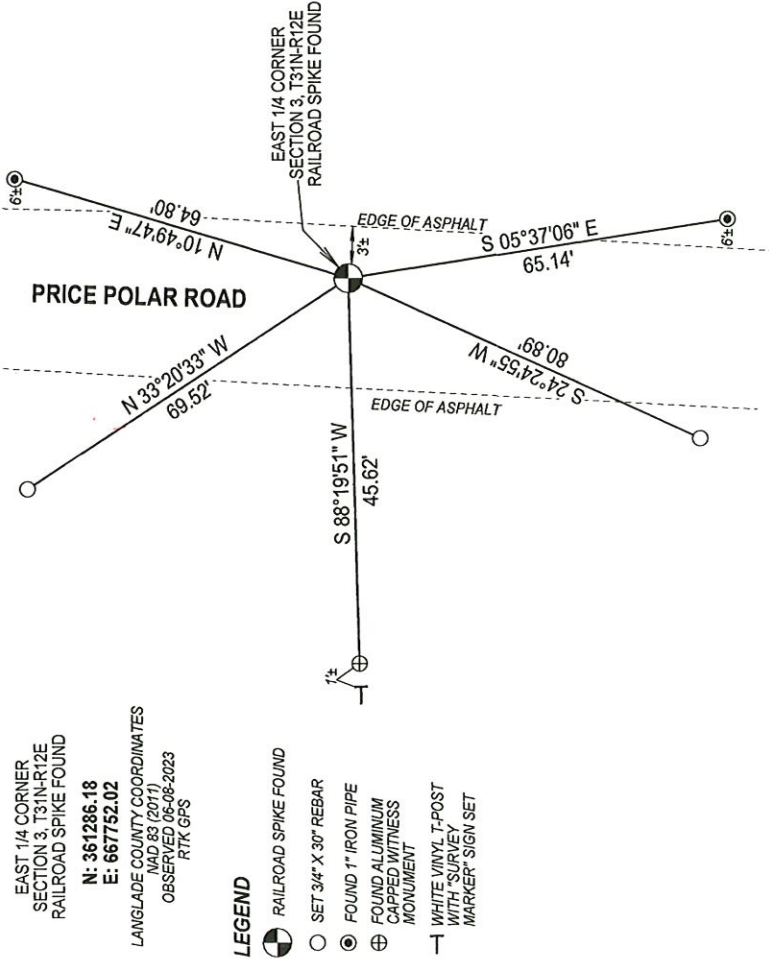

NOTES  
- SKETCH NOT DRAWN TO SCALE.  
- TIE BEARINGS SHOWN ARE LANGLADE COUNTY GRID BEARINGS.  
- ALL TIES MEASURED ELECTRONICALLY WITH TOTAL STATION.


SURVEYORS SEAL



I, Michael J. Hoffman, certify that the corner location shown on this record was determined by me or under my direction and control and that this U.S. Public Land Survey Monument Record is correct and complete to the best of my knowledge and belief.


Michael Hoffman 08-23-2023  
Signature Date

The EAST 1/4  
Corner of Section 3  
T. 31 N., R. 12 E.  
Langlade County, WI

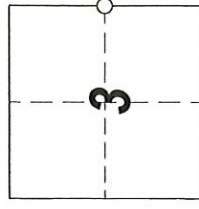

○ = Location of corner

 
INDEX No. **C-17** 4311203 2000



Stock No. 26273

# U. S. PUBLIC LAND SURVEY MONUMENT RECORD

INSTRUCTIONS: This record shall show the location of the corner and shall include all of the following nine elements (a through i).

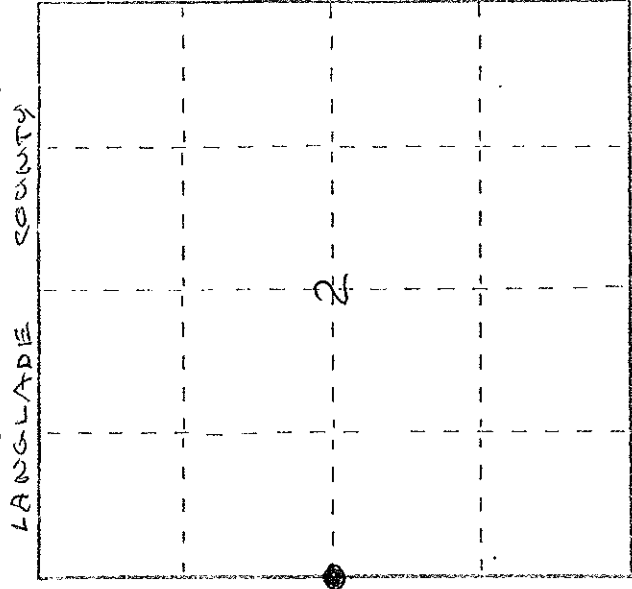

- (a) Identify the corner by reference to the U.S. public land survey system.
- O = Corner monument restored.


ORIGINAL CORNER ESTABLISHED  
 BY JAMES McBRIDE IN  
 NOV-DEC 1857

T 31 N R 12 E

- (b) Describe any record evidence, monument evidence, occupational evidence, testimonial evidence or any other material evidence you considered, and whether the monument was found or placed.  
 CORNER ESTABLISHED ON STRAIGHT LINE BETWEEN THE SW COR. AND NW COR. OF SECT 2 T31N R12E AND THE INTERSECTION OF E-W FENCE IDENTIFIED AS '4 LINE SET. RR. SPIKE IN PAVEMENT, SET WIT. MONUMENTS

- (c) In the plan view drawing below, provide reference ties to at least 4 witness monuments, or, if the location is within a municipality, to at least 2 witness monuments. (Witness monuments shall be made of concrete, natural stone, iron or other equally durable material.) Describe witness monuments.

- (d) Show a plan view drawing depicting the relevant monuments and reference ties which is sufficient in detail to enable accurate relocation of the corner monument if the corner monument is disturbed. Indicate north.

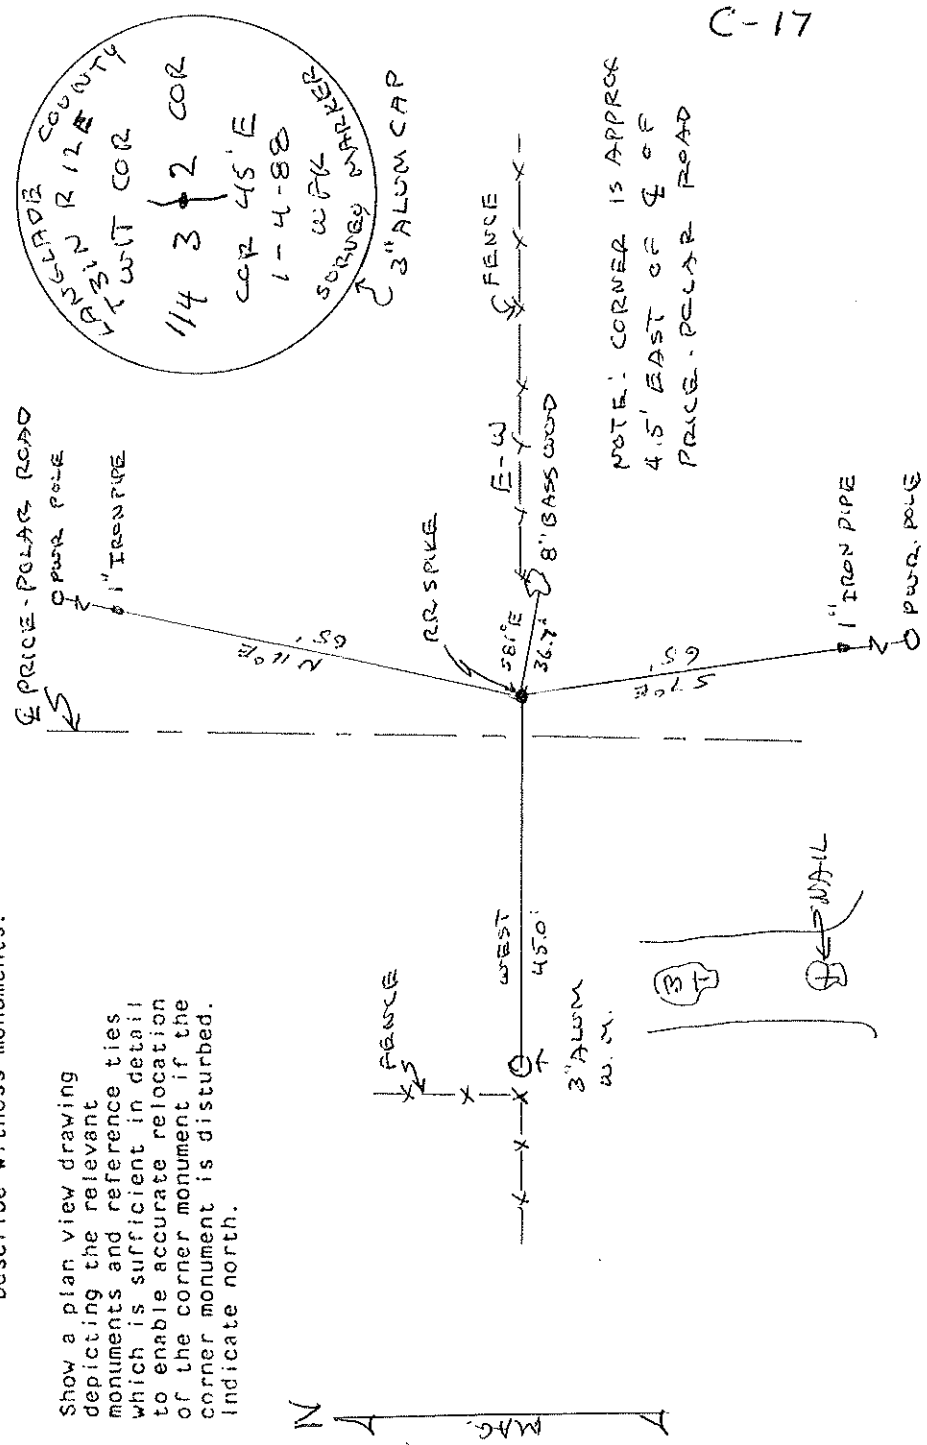


NOTE: CORNER IS APPROX  
 4.5' EAST OF E OF  
 PRICE-PELAR ROAD

(e) Describe any material discrepancy between the location of the corner as restored or reestablished and the location of that corner as previously restored or reestablished by distance and direction. Show the discrepancy on the plan view drawing under (d), above. Show the distances between the corner as previously restored or reestablished and (1) the corner as restored or reestablished, and (2) to at least 2 of the witness monuments shown on the drawing in (d), above.

*None*

(f) Was the corner restored through acceptance of (1) an obliterated evidence location, or, (2) a found perpetuated location? (1)

(g&h) Was the corner reestablished through lost corner proportionate methods? If so, show the method, including the directions and distances to other public land survey corners used as evidence or used for proportioning in determining the corner location?

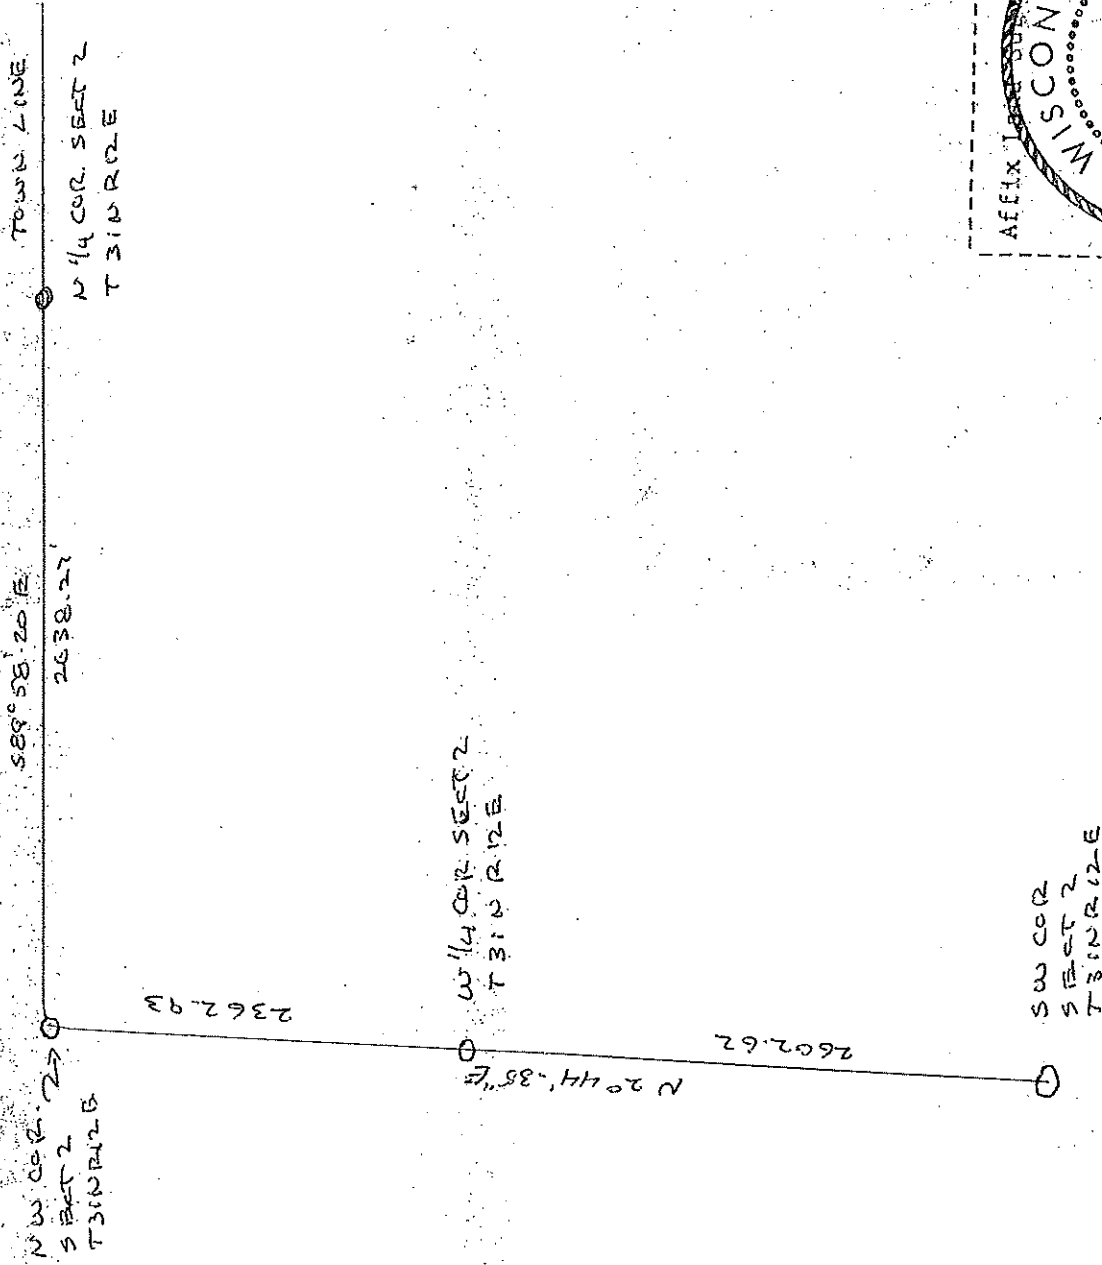

(1) WILLIAM F. KELLY  
 (Type or print name) certify that the corner location shown on this record was determined by me or under my direction and control and that this U.S. Public Land Survey Monument Record is correct and complete to the best of my knowledge and belief.

*William F. Kelly*  
 Signature

*1-4-88*  
 Date

