

U.S. PUBLIC LAND SURVEY MONUMENT RECORD

(Prepared and as required by S. A-E 7.08 WI Administrative Code)

The SOUTH 1/4 corner of Section 4, T. 31 N., R. 12 E., Langlade County, WI
 Corner was (check all that apply)

- Restored through acceptance of an obliterated evidence location.
- Restored through acceptance of a found perpetuated location.
- Determined to be lost and re-established through proportionate methods. (show bearings and distances to PLSS corners used for proportioning.)
- Restored/recovered/re-established in a location that differs from a previously established position. (Show difference in plan view below.)
- Check here if additional information is shown on the reverse side of this form.


Describe record evidence, recovered physical evidence, occupational evidence, testimonial evidence, and all other evidence considered in the recovery/restoration of the corner.

1857 - Original corner established by J. McBride - bearing trees: Sugar, 14", N2°E, 18 links; Sugar, 16", S33°E, 44 links.
 1988 - William Kelly "located iron rod at 3 way fence intersection, set 4" aluminum monument at corner. Fence lines mark the occupied boundaries." Kelly marked witness trees and filed a tie sheet.
 2023 - I found an existing brass capped iron pipe stamped by PLS-2119 in 2014. The existing brass capped iron pipe matches well with the location used by PLS 2114 on map #30604. I verified location from previous survey work in the area and remaining ties and set additional witness monuments.

Physical description of the monument set:

Accepted brass capped iron pipe as corner location and tied out as shown below.

Describe the accessories used to perpetuate the location of the corner. Include a plan view drawing and indicate accessories found/set. Describe measuring point on bearing trees. Show any topographic features that would aid in future recovery of the corner.

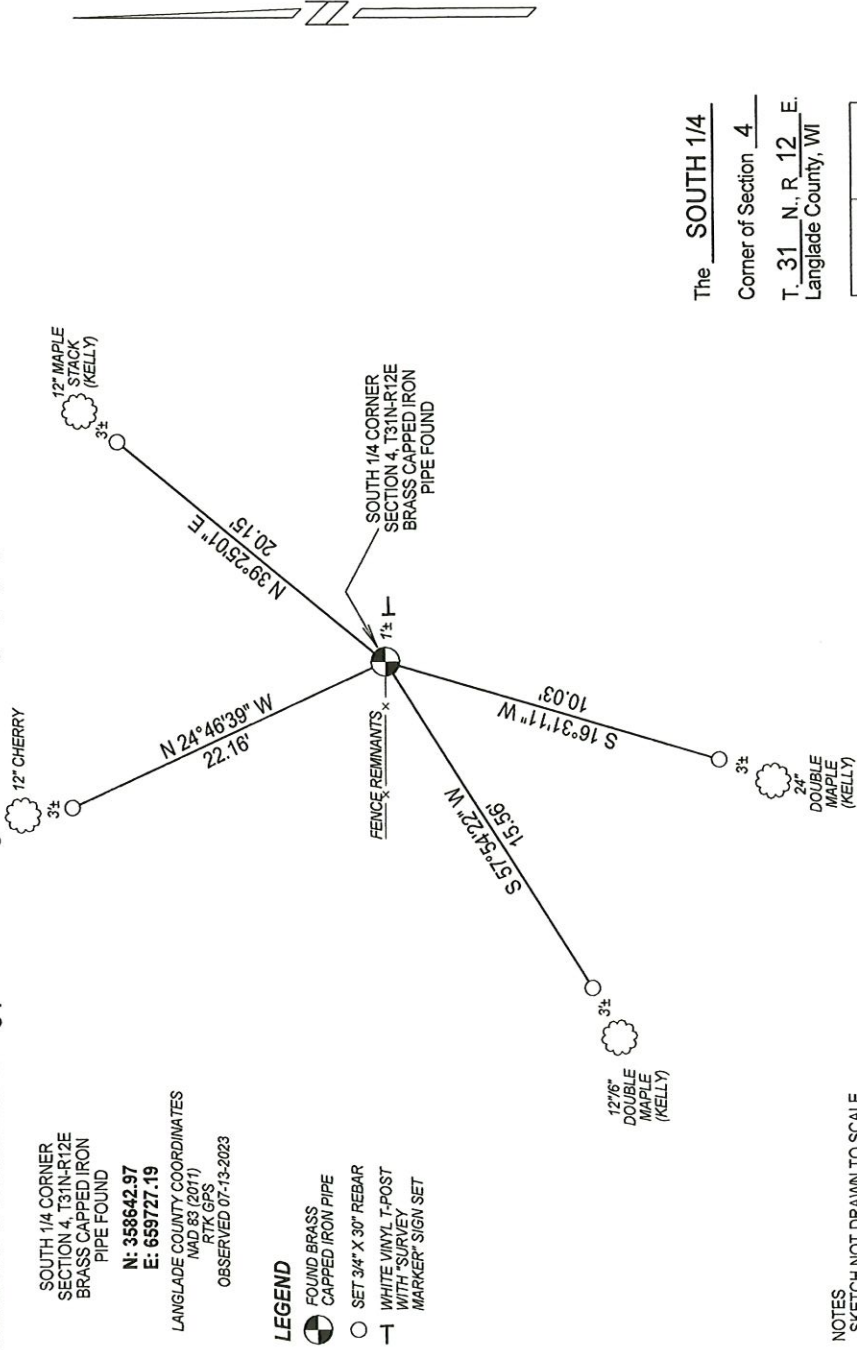


SOUTH 1/4 CORNER
 SECTION 4, T31N-R12E
 BRASS CAPPED IRON
 PIPE FOUND
 N: 358642.97
 E: 659727.19
 LANGLADE COUNTY COORDINATES
 (NO. 83 (2011)
 RTK GCS)
 OBSERVED 07-13-2023

LEGEND

- FOUND BRASS CAPPED IRON PIPE
- SET 3/4" X 30" REBAR
- WHITE VINYL T-POST WITH SURVEY MARKER SIGN SET

NOTES
 -SKETCH NOT DRAWN TO SCALE.
 -TIE BEARINGS SHOWN ARE ASSUMED.
 -ALL TIES MEASURED ELECTRONICALLY WITH TOTAL STATION.

The SOUTH 1/4
 Corner of Section 4
 T. 31 N., R. 12 E.
 Langlade County, WI

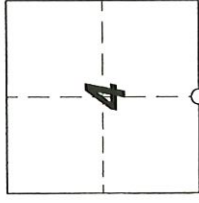


○ = Location of corner

SURVEYORS SEAL



I, Michael J. Hoffman, certify that the corner location shown on this record was determined by me or under my direction and control and that this U.S. Public Land Survey Monument Record is correct and complete to the best of my knowledge and belief.

 Michael J. Hoffman 09-11-2023
 Signature Date



Stock No. 26273


U. S. PUBLIC LAND SURVEY MONUMENT RECORD

INSTRUCTIONS: This record shall show the location of the corner and shall include all of the following nine elements (a through i).

- (a) Identify the corner by reference to the U.S. public land survey system.
- O = Corner monument restored.

ORIGINAL CORNER SET
 BY JAMES MC BRIDE
 IN JULY 1857

CORNER PERPETUATED BY
 M. HUTCHINSON

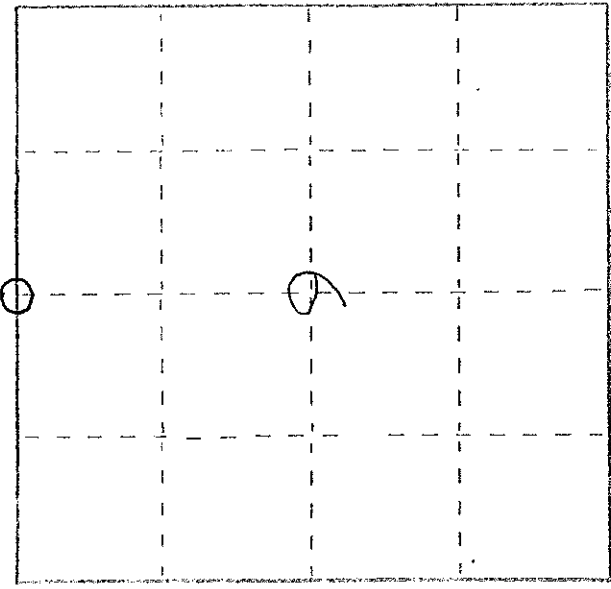



T 31 N R 12 E

- (b) Describe any record evidence, monument evidence, occupational evidence, testimonial evidence or any other material evidence you considered, and whether the monument was found or placed.

LOCATED IRON ROD AT 3WAY FENCE INTERSECTION.
 SET 4" ALUM MONUMENT AT CORNER. FENCE LINES
 MARK THE OCCUPIED BOUNDARIES

- (c) In the plan view drawing below, provide reference ties to at least 4 witness monuments, or, if the location is within a municipality, to at least 2 witness monuments. (Witness monuments shall be made of concrete, natural stone, iron or other equally durable material.) Describe witness monuments.

- (d) Show a plan view drawing depicting the relevant monuments and reference ties which is sufficient in detail to enable accurate relocation of the corner monument if the corner monument is disturbed. Indicate north.

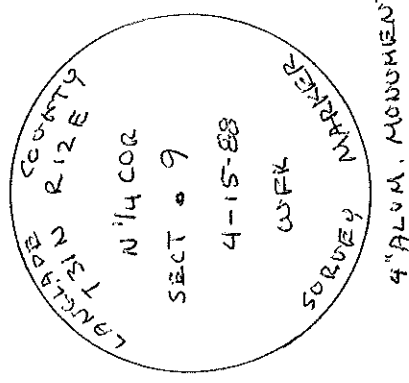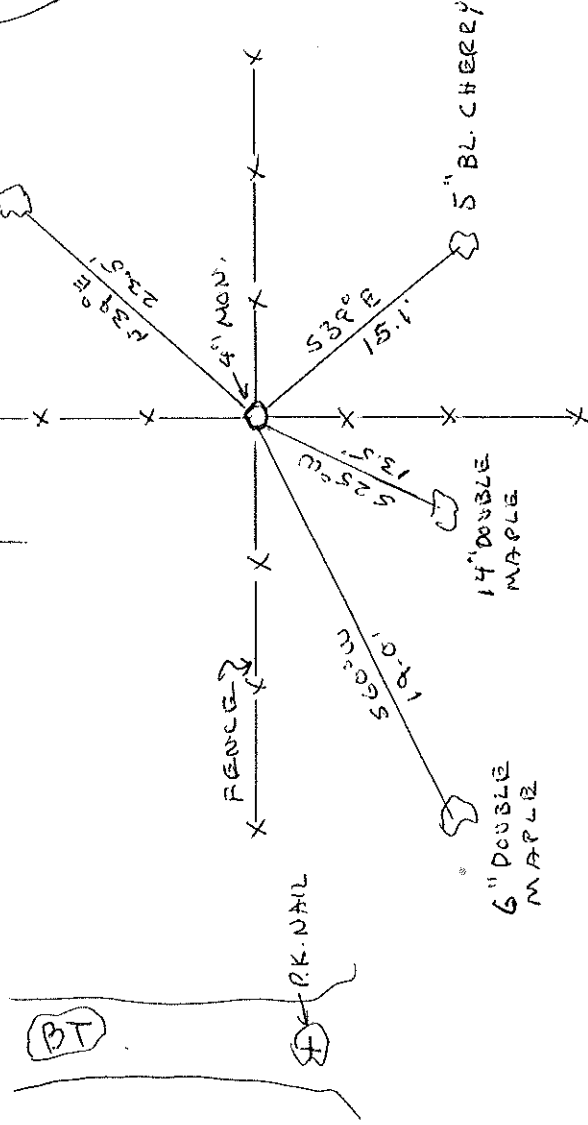

4" ALUM. MONUMENT

(e) Describe any material discrepancy between the location of the corner as restored or reestablished and the location of that corner as previously restored or reestablished by distance and direction. Show the discrepancy on the plan view drawing under (d), above. Show the distances between the corner as previously restored or reestablished and (1) the corner as restored or reestablished, and (2) to at least 2 of the witness monuments shown on the drawing in (d), above.


NONE

(f) Was the corner restored through acceptance of (1) an obliterated evidence location, or, (2) a found perpetuated location?

(2)

(g&h) Was the corner reestablished through lost corner proportionate methods? If so, show the method, including the directions and distances to other public land survey corners used as evidence or used for proportioning in determining the corner location?

NO

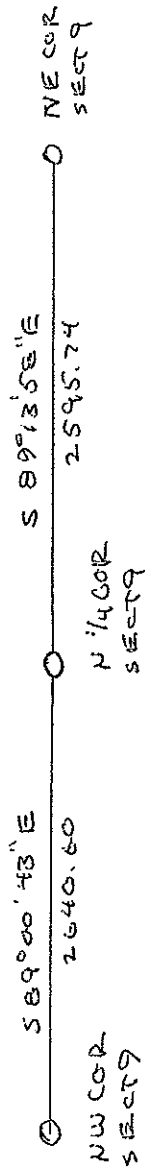

(1) WILLIAM F. KELLY

(Type or print name) certify that the corner location shown on this record was determined by me or under my direction and control and that this U.S. Public Land Survey Monument Record is correct and complete to the best of my knowledge and belief.

William F. Kelly
Signature

4-19-88
Date

Affix Land Surveyor Seal

