


3/12/05 2000

# U.S. PUBLIC LAND SURVEY MONUMENT RECORD

HISTORY OF ORIGINAL CORNER ESTABLISHMENT AND SUBSEQUENT RESTORATION AND DESCRIPTION OF ANY RECORD, MONUMENT OCCUPATIONAL, TESTIMONIAL OR OTHER EVIDENCE CONSIDERED:

THE ORIGINAL CORNER WAS ESTABLISHED IN 1857 BY JAMES MCBRIDE. ORIGINAL BEARING TREES: SUGAR MAPLE 14" N60W 16LKS., BIRCH 12" S82E 14LKS. BROOKS, IN1884, VISITED THE E1/4 AND RECORDED A DISTANCE OF 2622.84' FROM THE QUARTER CORNER TO THE SE COR OF THE SEC. HUTCHINSON, IN 1900, FOUND A "STONE 12X12X9 WITH X ON TOP" AT THE E1/4 OF SEC 5. WEBLEY (NO DATE, FIELD BOOK 130 IN COUNTY SURVEYOR'S OFFICE) VISITED THE E1/4 AND RECORDED A BEARING TREE: ELM 14" N601/2W 35 LKS. ON 4/25/01, DAN HIGGINBOTHAM AND GERRY BAHAR FOUND A E-W FENCELINE TO THE EAST 2638' NORTH OF THE SE COR OF THE SECTION. WE ALSO FOUND A 40 FENCE WITHIN 4' OF A PRORATED DISTANCE (CLOSING SECTION) TO THE NORTH. WE SET A 3/4" ROD ON CENTERLINE OF HWY S AND THE EXTENSION OF THE FENCELINE TO THE EAST, AND TIED OUT.

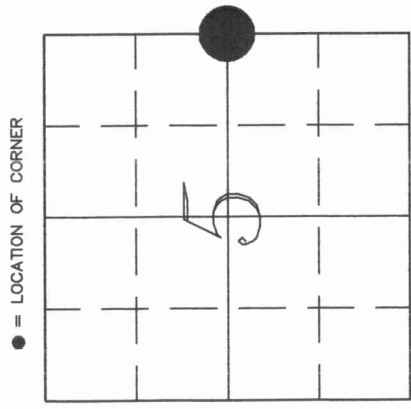

● = LOCATION OF CORNER


SECTION 5  
TOWNSHIP 31 NORTH, RANGE 12 EAST  
TOWN OF POLAR  
LANGLADE COUNTY, WISCONSIN

CORNER WAS: (CHECK ALL THAT APPLY)

- RESTORED THROUGH ACCEPTANCE OF AN OBLITERATED EVIDENCE LOCATION
- RESTORED THROUGH ACCEPTANCE OF A FOUND PERPETUATED LOCATION
- CONSIDERED A LOST CORNER AND REESTABLISHED THROUGH LOST CORNER PROPORTIONATE METHODS (INCLUDE A PLAN VIEW DRAWING SHOWING DISTANCES AND DIRECTIONS TO OTHER PUBLIC LAND SURVEY CORNERS USED FOR PROPORTIONING AND DETERMINING THE CORNER LOCATION)
- RESTORED OR REESTABLISHED IN A LOCATION THAT DIFFERS FROM A PREVIOUS RESTORATION OR REESTABLISHMENT (INCLUDE A PLAN VIEW DRAWING AND INDICATE WHAT WAS SET AND/OR FOUND)
- CHECK IF THERE IS ADDITIONAL INFORMATION ON BACK

DESCRIBE THE MONUMENT AND ACCESSORIES USED TO PERPETUATE THE LOCATION OF THE CORNER. (INCLUDE A PLAN VIEW DRAWING AND INDICATE WHAT WAS SET AND/OR FOUND) ALSO INCLUDE FOUR TIES TO THE SECTION CORNER AND DESCRIPTION OF THE TIES.

PP #3112-5E19

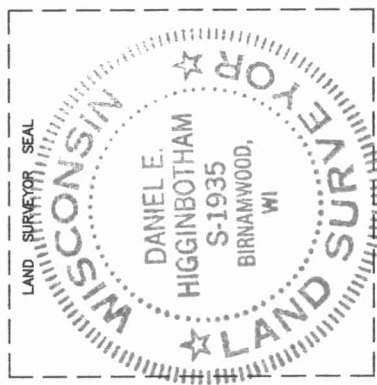

DANIEL E. HIGGINBOTHAM

(type or print name) CERTIFY THAT THE CORNER LOCATION SHOWN ON THIS RECORD WAS DETERMINED BY ME OR UNDER MY DIRECTION AND CONTROL AND THAT THIS U.S. PUBLIC LAND SURVEY MONUMENT RECORD IS CORRECT AND COMPLETE TO THE BEST OF MY KNOWLEDGE AND BELIEF.

*D. Higginbotham*  
SIGNATURE

3/19/02  
DATE

29

INDEX NO.

