

CERTIFIED LAND CORNER RESTORATION

Index No. 2-17

State of Wisconsin }  
County of Langlade } ss.

History of original corner establishment:  
Old survey notes and Highway records

I Gary A. Radtke, do hereby certify that on the 8<sup>th</sup> day of June, 1978, I found evidence of the W<sup>1</sup>/<sub>4</sub> Corner corner of Section 14 Township 31, North, Range 12 East, Fourth Principal Meridian, as described hereon; and that from this evidence I established a new monument and accessories as described hereon to perpetuate the original location of this corner.



Description of corner evidence found: None



Resident witnesses:

Description of monument and accessories I established to perpetuate the original location of this corner.

FORM 985 H. C. MILLER CO., MILWAUKEE

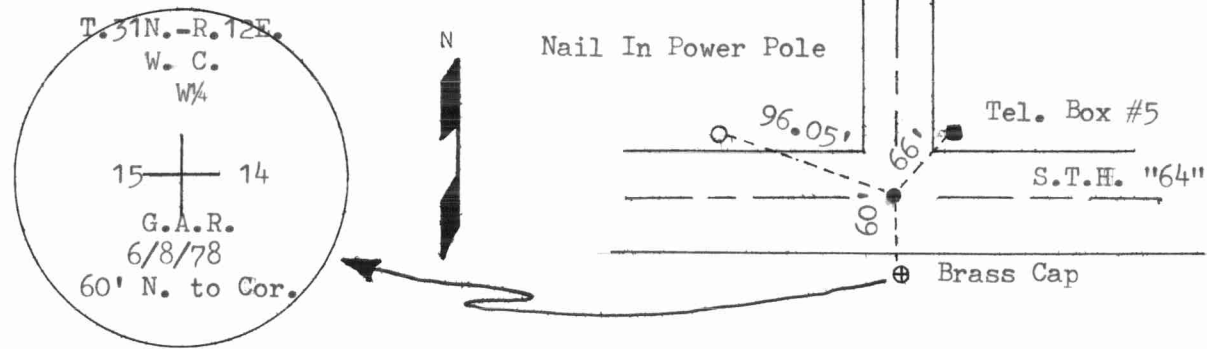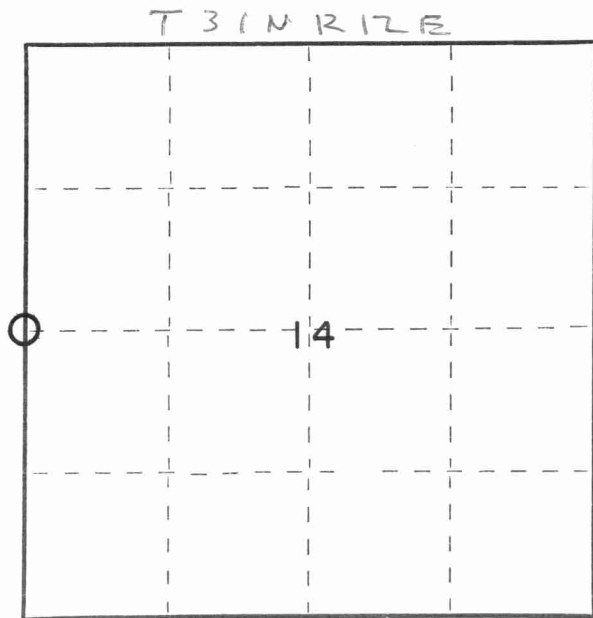

Dated at Antigo, Wis., this 29<sup>th</sup> day of June, 1978

Signature Gary A. Radtke Title Registered Land Surveyor Registration No. S-1248  
(County Surveyor, Registered Land Surveyor, or other duly authorized official)

Office of Register of Deeds, County of \_\_\_\_\_, I hereby certify that the within instrument was filed in this office for record on the \_\_\_\_\_ day of \_\_\_\_\_, 19\_\_\_\_ at \_\_\_\_\_ o'clock \_\_\_\_\_ M.

(Register of Deeds)

By \_\_\_\_\_ Deputy

○ = Corner monument restored.

