

CERTIFIED LAND CORNER RESTORATION

Index No. L-13

State of Wisconsin }  
County of Langlade } ss.

I, Thomas R. Arnott, do hereby certify that on the 25 day of July, 1978, I found evidence of the 1/4 corner of sections 15 and 16 Township 31, North, Range 12 E, Fourth Principal Meridian, as described hereon; and that from this evidence I established a new monument and accessories as described hereon to perpetuate the original location of this corner.

History of original corner establishment:


Orig. by James McBride  
Nov. 21 thru Dec. 1, 1857

Birch 20 S62W 40  
Lind 18 S32E 27

Description of corner evidence found:

Found R.R. spike in center of intersection of S.T.H. "64" and Polar Road

Resident witnesses:

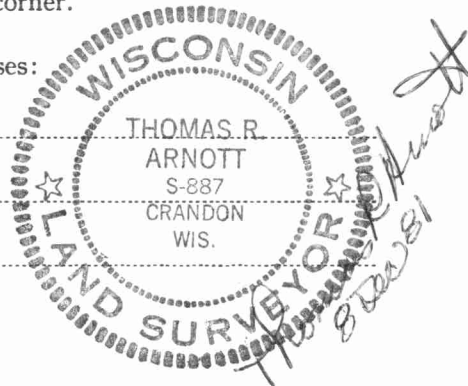


Description of monument and accessories I established to perpetuate the original location of this corner.

Left R.R. spike as found.

Ties:

Power Pole WP&L 31-12-16 53/26 P.K. in NE side N38W 40.10 feet  
Telephone Pole #1242 P.K. SE side N30E 66.78 feet  
Northeast fuel filler cap (center) S39E 40.66 feet  
NW corner concrete block building S30E 76.97 feet  
Telephone pole #376 S78W 110.70 feet

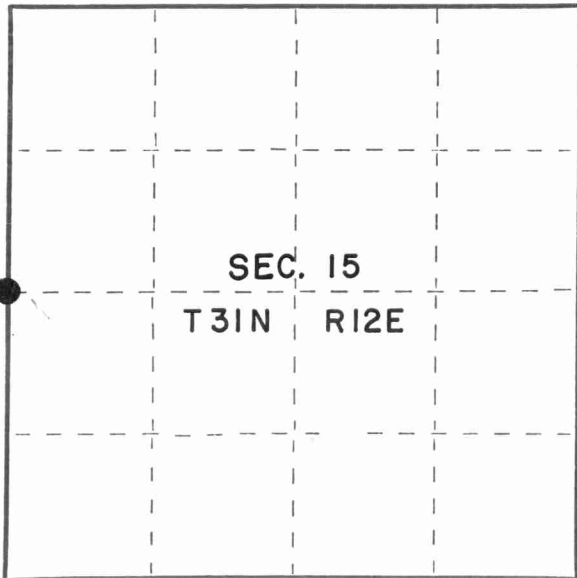

○ = Corner monument restored.

Dated at Crandon, Wis., this 8th day of December, 1981

Signature Thomas R. Arnott Title Surveyor Registration No. S-887  
(County Surveyor, Registered Land Surveyor, or other duly authorized official)

Office of Register of Deeds, County of Langlade, I hereby certify that the within instrument was filed in this office for record on the \_\_\_\_\_ day of \_\_\_\_\_, 19\_\_\_\_ at \_\_\_\_\_ o'clock \_\_\_\_\_ M.

(Register of Deeds)

By \_\_\_\_\_ Deputy

