

~~LANGLAF~~

COUNTY

FILE:

SE N 29
TOWN 31
RANGE 12 E


Survey monument record

TYPE OF MONUMENT: Stone with chis X

STATE PLANE COORDINATE: N _____
E _____

ELEVATION - M.S.L. DATUM: _____

THETA ANGLE: _____

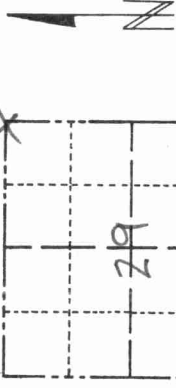

BASIS FOR MONUMENT LOCATION

(Use reverse side if necessary)


Research revealed no information of any surveys that have been performed since the original government survey. Dug for monument with backhoe and discovered a stone with chiseled x about 2.5 feet below black top. Accepted as correct.

LOCATION
(Indicated by 'X')

TIE SKETCH

(Show at least three ties)

bottle caps set.

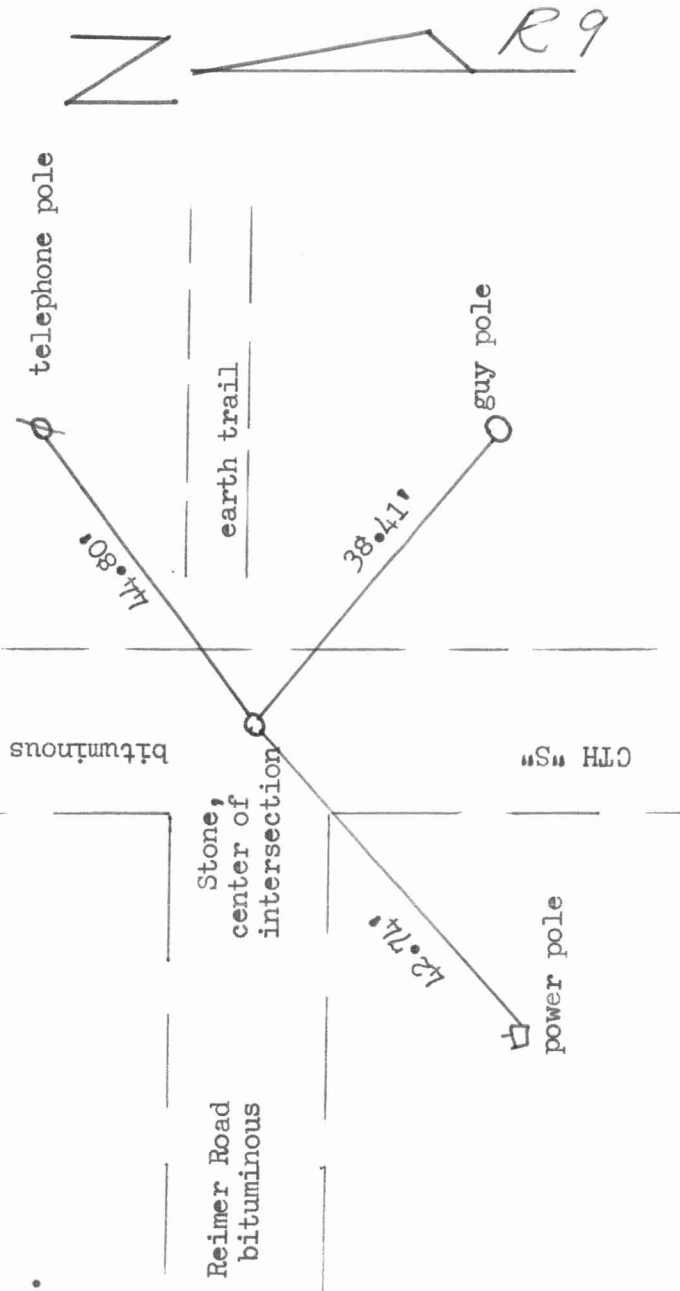

CERTIFIED CORRECT:
Keith R. [Signature]
REGISTERED LAND SURVEYOR
DATE: 9-2-96

