

U.S. PUBLIC LAND SURVEY MONUMENT RECORD

(Prepared and as required by S. A-E 7.08 WI Administrative Code)

The EAST Quarter corner of Section 28, T. 31 N., R. 12 E., Langlade County, WI

Corner was: (check all that apply)

- Restored through acceptance of an obliterated evidence location.
- Restored through acceptance of a found perpetuated location.
- Determined to be lost and re-established through proportionate methods.
- (Show bearings and distances to PLSS corners used for proportioning.)
- Restored/recovered/reestablished in a location that differs from a previously established position. (Show difference in plan view below.)

Check here if additional information is shown on the reverse side of this form.

Describe record evidence, recovered physical evidence, occupational evidence, testimonial evidence and all other evidence considered in the recovery/restoration of the corner.

The original corner was established in 1857 by James McBride. Original BT's: sugar, 8", S70°E, 20 links, and a hemlock, 10", N85°W, 30 links. In 1882, B.F. Dorr surveyed the E-W quarter lines through Sections 27 & 28, but didn't describe this corner. Hutchinson (circa 1933) surveyed the E-W quarter line in Section 28 (79.80 1/2 chains) and described this corner as "1/4 post bet. 27-28. Cheese factory, N42°E, 86'". R.W. Nordin, in 1977, described this corner as "Found remains of old wood stake under surface of road". He set a 2" x 48" iron pipe with brass cap and set three tie pipes. 7/29/99 Dave Thulst, Dean Williams dug at Hutchinson's distance from the corner of an old foundation to the NE. Found stone in road, upright with chiseled notch on top. The stone measures 0.45' ± x 0.8' ± x depth unknown. We uncovered the top 12 inches of the stone and it was still very solid. We also dug 2' northwesterly and 5' southeasterly of this stone and found no other stones of any size. It is obvious that this stone was set upright and marked the corner. I accept it as the best evidence of the corner.

Physical description of the monument set: * Ø 8.6 CHAINS (56.76') DT.


I left the stone found in place and made the chiseled notch into a chiseled "+" To aid in finding the stone again at a later date, I set a 1" x 30" iron pipe 0.35' ± west of the chiseled "+". Stone is 1' below the road surface.

Describe the accessories used to perpetuate the location of the corner. Include a plan view drawing and indicate accessories found/set. Describe measuring point on bearing trees. Show any topographic features that would aid in future recovery of the corner.

⊗ = 3/4" x 30" rebar set flush


● = 3/4" iron pipe found

▼ = white vinyl sign post with "Survey Marker" sign set

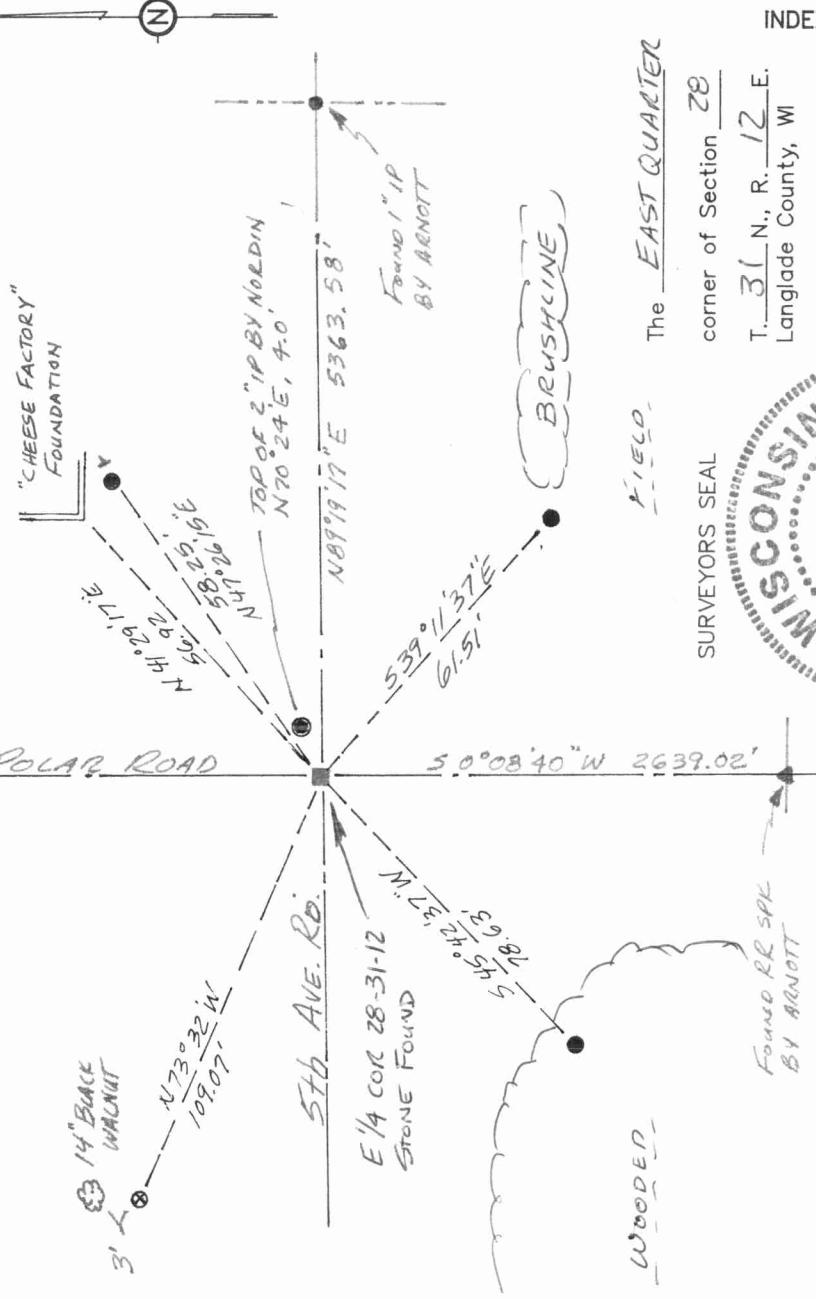

corner of Section 28
T. 31 N., R. 12 E.
Langlade County, WI

INDEX No. T13

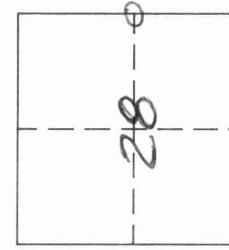

○ = Location of corner



Date

I, DAVID E. TRUSTY, LANGLADE COUNTY SURVEYOR, certify that the corner location shown on this record was determined by me or under my direction and control and that this U.S. Public Land Survey Monument Record is correct and complete to the best of my knowledge and belief.

David E. Trusty 01/21/99
Signature
Date

WISCONSIN ADMINISTRATIVE CODE

Note: A copy of the board-approved form is available from the Department of Regulation and Licensing, Bureau of Business and Design Professions, 1400 East Washington Avenue, P.O. Box 8935, Madison, Wisconsin 53708.

(3) MONUMENT RECORD REQUIREMENTS. A U.S. public land survey monument record shall show the location of the corner and shall include all of the following elements:

- (a) The identity of the corner, as referenced to the U.S. public land survey system;

- (b) A description of any record evidence, monument evidence, occupational evidence, testimonial evidence or any other material evidence considered by the surveyor, and whether the monument was found or placed;

- (c) Reference ties to at least 4 witness monuments. Witness monuments shall be concrete, natural stone, iron, bearing trees or other equally durable material, except wood other than bearing trees;

- (d) A plan view drawing depicting the relevant monuments and reference ties which is sufficient in detail to enable accurate relocation of the corner monument if the corner monument is disturbed;

- (e) A description of any material discrepancy between the location of the corner as restored or reestablished and the location of that corner as previously restored or reestablished;

- (f) Whether the corner was restored through acceptance of an obliterated evidence location or a found perpetuated location;

- (g) Whether the corner was reestablished through lost-corner-proportionate methods;

- (h) The directions and distances to other public land survey corners which were used as evidence or used for proportioning in determining the corner location; and,

- (i) The stamp and signature or seal and signature of the land surveyor under whose direction and control the corner location was determined and a statement certifying that the U.S. public land survey monument record is correct and complete to the best of his or her knowledge and belief.

History: Cr. Register, February, 1987, No. 374, eff. 3-1-87; am. (1) and (3)(c), Register, May, 1989, No. 401, eff. 6-1-89.

E 1/4 corner, Section 28-31-12

Corner stone witnessed by:

David E. Thlusty, RLS, Langlade County Surveyor

Dean Williams, survey assistant

Tom Arnott, RLS

Paul Schuman, adjoining landowner