

4311305 0620 2017

**U.S. PUBLIC LAND SURVEY MONUMENT RECORD**  
*APPROX.*

(Prepared and as required by S. A-E 7.08 WI Administrative Code)

The 5 1/4 corner of Section 5, T. 31 N., R. 13 E., Langlade County, WI

Corner was: (check all that apply)

- Restored through acceptance of an obliterated evidence location.
  - Restored through acceptance of a found perpetuated location.
  - Determined to be lost and re-established through proportionate methods.  
(Show bearings and distances to PLSS corners used for proportioning.)
  - Restored/recovered/reestablished in a location that differs from a previously established position. (Show difference in plan view below.)
  - Check here if additional information is shown on the reverse side of this form.
- Describe record evidence, recovered physical evidence, occupational evidence, testimonial evidence and all other evidence considered in the recovery/restoration of the corner.**


*THIS SHEET MADE ONLY FOR THE PURPOSE OF  
RECORDING APPROXIMATE COORDINATES ON AN IRON PIPE  
WITH CAP FOUND BY DALE CARLSON.  
FURTHER HISTORY & PHYSICAL EVIDENCE VERIFICATION  
IS NEEDED.*

Physical description of the monument set:

Describe the accessories used to perpetuate the location of the corner. Include a plan view drawing and indicate accessories found/set. Describe measuring point on bearing trees. Show any topographic features that would aid in future recovery of the corner.

*COORDS REPORTED BY D. CARLSON:*

*N 363652  
E 686489*

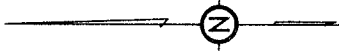


*Prepared By  
Dr. Ruson  
8/17/17*

SURVEYORS SEAL

*APPROX*  
The 5 1/4  
corner of Section 5  
T. 31 N., R. 13 E.  
Langlade County, WI

INDEX No. \_\_\_\_\_

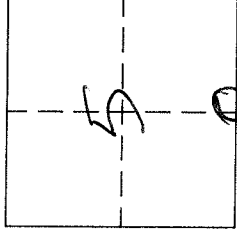

O = Location of corner

I, \_\_\_\_\_, certify that the corner location shown on this record was determined by me or under my direction and control and that this U.S. Public Land Survey Monument Record is correct and complete to the best of my knowledge and belief.

Signature \_\_\_\_\_

Date \_\_\_\_\_