

CERTIFIED LAND CORNER RESTORATION

31-13 Index No. J-9

State of Wisconsin }
County of Lan glade } ss.

History of original corner establishment:

I Raymond J. Hallisy, do hereby certify that on the 20th day of July, 1968, I found evidence of the Section corner of 8 9 17 16 Township 31, North, Range 13, Fourth Principal Meridian, as described hereon; and that from this evidence I established a new monument and accessories as described hereon to perpetuate the original location of this corner.

Description of corner evidence found:


Found ~~squared~~ stake standing in rock mound. Cruiser marks on Hemlock S4E 21' ~~7"~~, Aspen S32W 9' 3", and Aspen N44E 15' 5"

Resident witnesses:

.....
.....
.....

Description of monument and accessories I established to perpetuate the original location of this corner.

Set Brass Cap in cement 3' deep ~~12~~ 4" thick, ~~112~~ 1 1/2' above ground

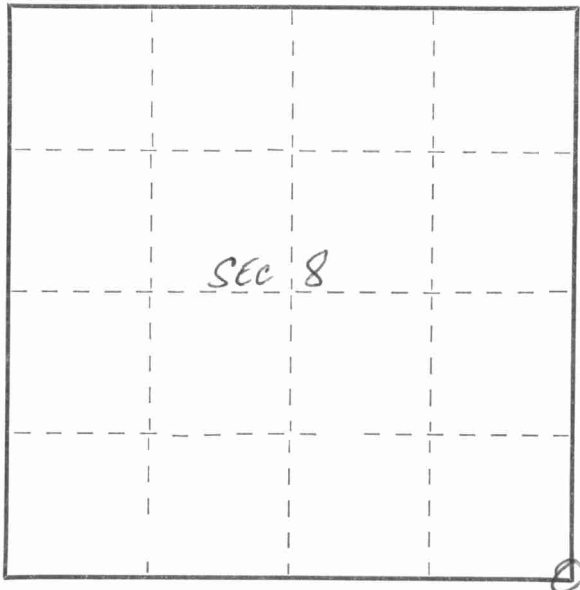

8" RED MAPLE
N21W 28'
SCRIBED BT

BC

14" HEMLOCK
S4E 21' 7"
SCRIBED BT



Dated at Antigo, Wis., this 20th day of July, 1968

Signature Raymond J. Hallisy Title Reg. Land Surveyor Registration No. 685
(County Surveyor, Registered Land Surveyor, or other duly authorized official)

Office of Register of Deeds, County of _____, I hereby certify that the within instrument was filed in this office for record on the _____ day of _____, 19____ at _____ o'clock _____ M.

(Register of Deeds)

By _____ Deputy

○ = Corner monument restored.

FORM 985 H. C. MILLER CO., MILWAUKEE

