

# U.S. PUBLIC LAND SURVEY MONUMENT RECORD


Note: This form is intended and designed to fulfill all requirements of Wisconsin Administrative Code, Chapter A-E 7.08 U.S. Public Land Survey Monument Record (3) (a) (b) (c) (d) (e) (f) (g) (h) (i). An additional sheet may be added if necessary to conform with said requirements.

(a) Corner location: Township 31 North

Range 14 East West

Town/City/Village Wolf River

County Langlade

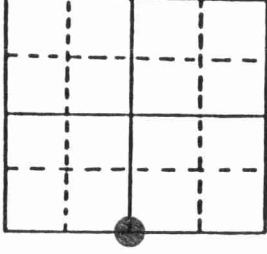

Section 7

(b) (f) (g) (h) Description of monument found at this corner and if it was accepted, state all evidence (material, testimonial, occupational, plats, records, other monuments) used as a basis for accepting. If not accepted or if nothing was found, state evidence used as basis for establishing location. If reestablished through lost corner proportionate methods, indicate all monuments, distances and directions used to establish. Indicate type of monument found or set and sign post.

6/25/1857 - Artemis Curtis established this corner at 40.00 chains and set a wood post with two BTs:

12" Sugar, N57°E, 53 Links (34.98') 20" Y. Birch, N86°W, 25 Links (16.5')


1973 - Vreeland set 2" iron pipe for corner.

7/7/1992 - Milo E. Stefan found Vreeland's iron pipe. As no original evidence of this corner could be located, I restore this corner on the fence line for Departure and Mid-point for Latitude. We placed an aluminum monument and made four new BTs.

(c) (d) (e) Plan view of corner with ties to at least 4 witness monuments. If in disagreement with previously established corner, show the distances between the two corners and also indicate the ties to the disputed corner.

- 1) 2" x 42" Aluminum monument in mound of stone.
- 2) 8" Sugar Maple, N43°E, 19.30'.
- 3) 6" Sugar Maple, S37°E, 5.16'.
- 4) 10" Sugar Maple, S55°W, 16.13'.
- 5) 11" Basswood, N38°W, 20.64'.
- 6) Vreeland's 2" iron pipe, S50°-48'-13"W, 13.03'.
- 7) Plastic sign post, East, 1.2'.

Distances to nail in side of BTs.  
Stump blaze scribed "BT."

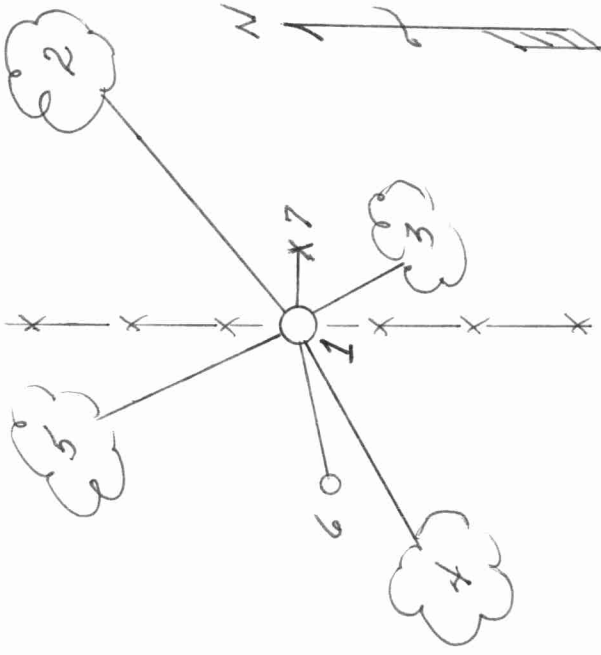

(i) I, Milo E. Stefan

(type or print name) certify that the corner location on this record was determined by me or under my direction and control and that this U.S. Public Land Survey Monument Record is correct and complete to the best of my knowledge and belief.

Milo E. Stefan

Signature

July 15, 1992

Date



Index No. G-1

Stamp

