

CERTIFIED LAND CORNER RESTORATION

31-13


Index No. J-13

State of Wisconsin }
County of Langlade } ss.

I, Raymond J. Hallisy, do hereby certify that on the 3rd day of July, 1971, I found evidence of the Section corner of 9, 10, 15, & 16 Township 31, North, Range 13E, Fourth, Principal Meridian, as described hereon; and that from this evidence I established a new monument and accessories as described hereon to perpetuate the original location of this corner.

Resident witnesses:

.....
.....
.....

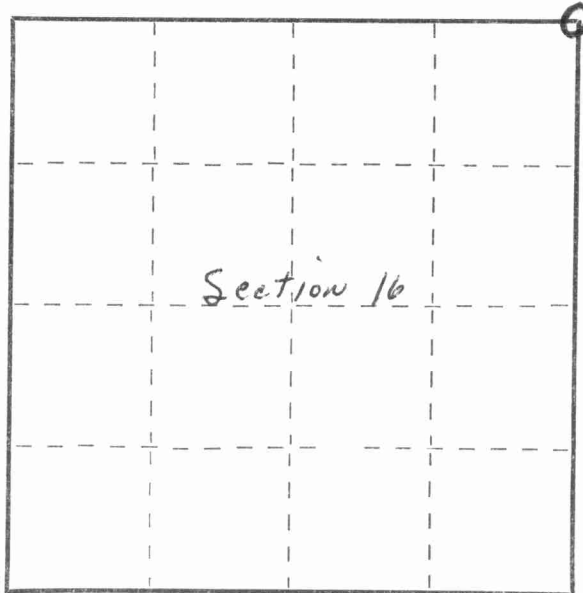

○ = Corner monument restored.

History of original corner establishment:

Description of corner evidence found:

Found old Wood stake marked S9 S10 S15 S16

Description of monument and accessories I established to perpetuate the original location of this corner.

Set 2" pipe with brass cap, and wood post marked 9, 10, 15, & 16

BT's to corner

Cedar 7" S31W 9 Feet 11 inches
Cedar 7" S46E 11 Feet 7 inches
Cedar 5" N50E 4 Feet 9 inches

BT&S faced at base of tree and scribed BT



Dated at Antigo, Wis., this 3rd day of July, 1971.

Signature R J Hallisy Title Reg. Land Surveyor Registration No. 685
(County Surveyor, Registered Land Surveyor, or other duly authorized official)

Office of Register of Deeds, County of _____, I hereby certify that the within instrument was filed in this office for record on the _____ day of _____, 19____ at _____ o'clock _____ M.

.....
(Register of Deeds)

By _____ Deputy

FORM 985 H. C. MILLER CO., MILWAUKEE

