

CERTIFIED LAND CORNER RESTORATION

Index No. I-21

State of Wisconsin }
County of VILAS } ss.

I, F.H. COPP, do hereby
certify that on the 5th day
of MAY, 1980, I found
evidence of the NW
corner of Section 13
Township 31, North, Range
13 East, Fourth Principal Meridian,
as described hereon; and that from this evidence
I established a new monument and accessories
as described hereon to perpetuate the original
location of this corner.

Resident witnesses:

Arnold Buettner

History of original corner establishment:


Orig. BTs. Cedar 8" N12°W 26 lks
Cedar 8" N62°E 36 lks
Cedar 8" S12°E 16 lks
Spruce 10" S48°W 12 lks

Description of corner evidence found: 3 1/2" Post point below swamp
2" Picket point alongside.


N12°W Downed Cedar root throw @ correct bearing & distance.
NE Rotten leaning Cedar stump, correct size & location when lean is adjusted.
SE Rotten Cedar stump with flat face & overgrowth axe work on west side of overgrowth.
SW Large rotten stump identified as Spruce.
All remains check within 1 link of original.

Description of monument and accessories I established to perpetuate the original location of this corner.

Set 2" Langlade Co. type Brass Cap.
BTs. Cedar 5" N48°W 9.25'
Cedar 6" N58°E 7.00'
Cedar 9" S07°E 21.10'
Cedar 10" S68°W 17.30'

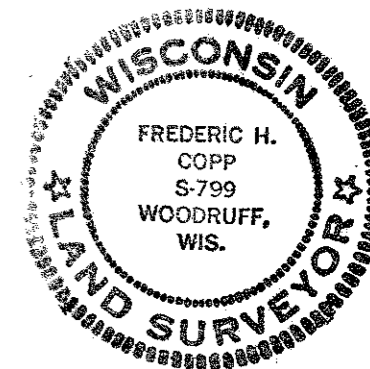

FORM 985 H. C. MILLER CO., MILWAUKEE

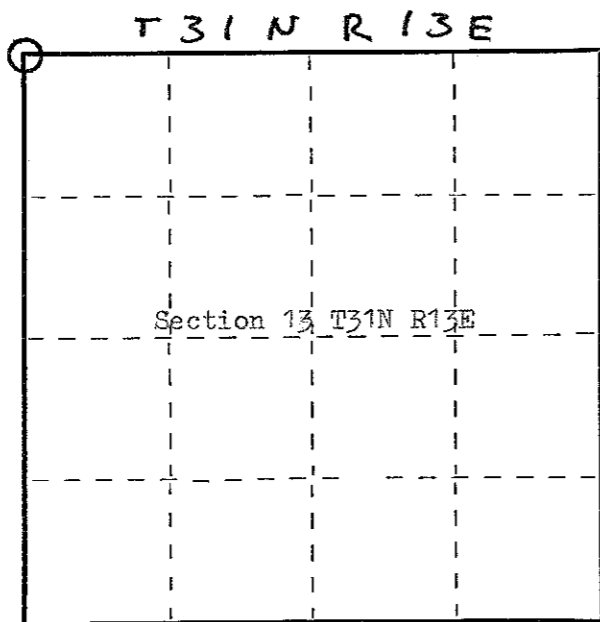

○ = Corner monument restored.

F.H. Copp Surveyor
Norbert L. Vissers Crew Chief

Dated at Boulder Junction, Wis., this 3rd day of September, 1980

Signature F.H. Copp Title _____ Registration No. _____
(County Surveyor, Registered Land Surveyor, or other duly authorized official)

Office of Register of Deeds, County of _____, I hereby certify that the within
instrument was filed in this office for record on the _____ day of _____, 19____
at _____ o'clock _____ M.

(Register of Deeds)

By _____ Deputy