

CERTIFIED LAND CORNER RESTORATION

Index No. ~~G-17~~

G-21

State of Wisconsin }
County of Lincoln } ss.

I, Raymond J. Hallisy, do hereby certify that on the 20th day of January, 1980, I found evidence of the 1/4 corner of Section 11, Township 31, North, Range 13E, Fourth Principal Meridian, as described hereon; and that from this evidence I established a new monument and accessories as described hereon to perpetuate the original location of this corner.

Resident witnesses:

.....
.....
.....

History of original corner establishment:

Description of corner evidence found:



Squared wood post, location poster on a Elm N25E 20' 7" on the south edge of the old fire line.

Description of monument and accessories I established to perpetuate the original location of this corner.

Set a 2" iron pipe with brass cap.

New FT's

10" Hard Maple S13W 6' 7"
10" Hard Maple N48W 9'
8" Hard Maple N27E 9' 9"

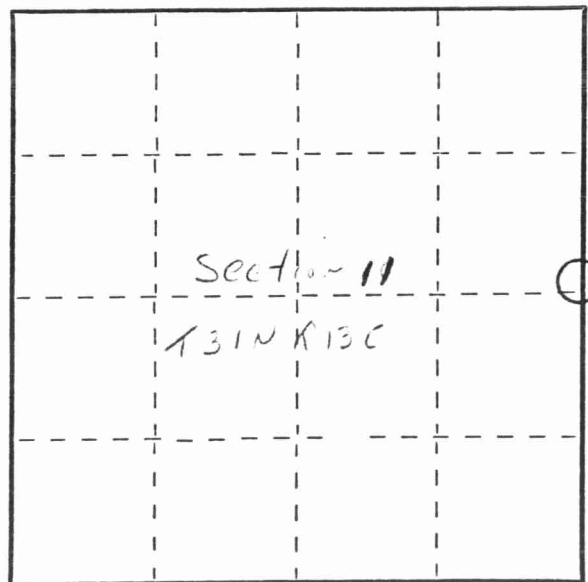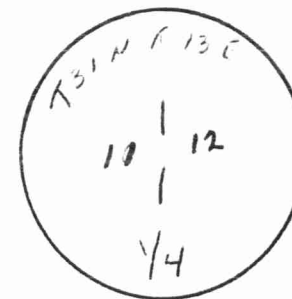

○ = Corner monument restored.

Dated at Antigo, Wis., this 20th day of January, 1980.

Signature Raymond J. Hallisy Title Land Surveyor Registration No. 5-685
(County Surveyor, Registered Land Surveyor, or other duly authorized official)

Office of Register of Deeds, County of....., I hereby certify that the within instrument was filed in this office for record on the..... day of....., 19..... at..... o'clock..... M.

.....
(Register of Deeds)

By..... Deputy

FORM 985 H. C. MILLER CO., MILWAUKEE

