

U.S. PUBLIC LAND SURVEY MONUMENT RECORD


Note: This form is intended and designed to fulfill all requirements of Wisconsin Administrative Code, Chapter A-E 7.08 U.S. Public Land Survey Monument Record (3) (a) (b) (c) (d) (e) (f) (g) (h) (i). An additional sheet may be added if necessary to conform with said requirements.

(a) Corner location: Township 31 North

Range 14 East/West

Town/City/Village _____ Wolf River

County _____ Langlade

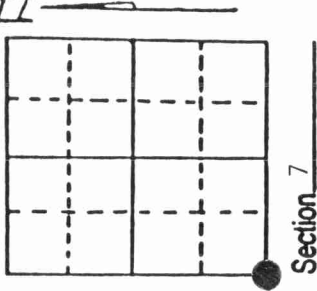

(b) (f) (g) (h) Description of monument found at this corner and if it was accepted, state all evidence (material, testimonial, occupational, plats, records, other monuments) used as a basis for accepting. If not accepted or if nothing was found, state evidence used as basis for establishing location. If reestablished through lost corner proportionate methods, indicate all monuments, distances and directions used to establish. Indicate type of monument found or set and sign post.

6/25/1857 - Artemis Curtis established this corner at 80.00 chains, set a wood post and made four BTs:

16" Basswood, N59°E, 16 Links (10.56')

14" Hemlock, S50°W, 75 Links (49.50')

24" Hemlock, S3½°E, 17 Links (11.22')

36" Y. Birch, N37°W, 17 Links (11.22')

6/14/1898 - Dorr found corner and used it to measure Easterly 2.0 miles.

1901 & 1902 - Webly was here and found two original BTs and set stone with "+" for corner. Webly measured from Quarter Corner South and found distance to be 40.16½ chains (2650.89').

11/16/1913 - Brooks in the subdivision of Section 18, found Webly stone and measured South (40.15 chains) and East (38.42 chains).

1973 - Vreeland set 2" iron pipe for corner.


6/26/1992 - Milo E. Stefan found Vreeland's iron pipe in fence line North and South.

Upon investigation and evaluation of past surveys and evidence on the ground, I restore this corner by using the North - South fence for departure, and the distance from Quarter Corner one-half mile South of 2650.89' as established corner, show the distances between the two corners and also indicate the ties to the disputed corner.

returned by Webly in his 1901 and 1902 measure. Brooks distance is also very close (2649.90').

- 1) 2" x 42" aluminum monument in mound of stone.
- 2) 8" White Ash, N53°E, 119.78'.
- 3) 8" Basswood, S45°E, 80.62'.
- 4) 12" Sugar Maple, N3°E, 73.62'.
- 5) 2" iron pipe by Vreeland S0°-55'-06"W, 19.49'.
- 6) Plastic sign post, West, 1.3'.

Distances to nail in side of BTs.
Stump blaze scribed "BT".

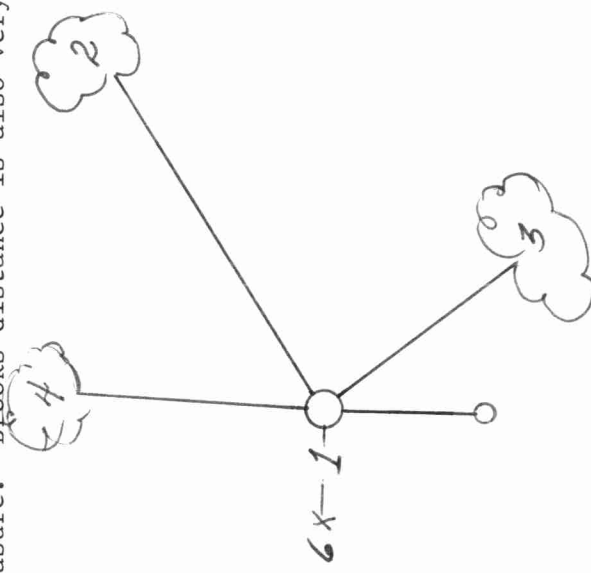

(i) I, Milo E. Stefan

(type or print name) certify that the corner location on this record was determined by me or under my direction and control and that this U.S. Public Land Survey Monument Record is correct and complete to the best of my knowledge and belief.

Milo E. Stefan

Signature

July 15, 1992

Date



Index No. J-1

Stamp

