

CERTIFIED LAND CORNER RESTORATION

Index No. G-1

State of Wisconsin }
County of Wood } ss.

I Keith R. Vreeland, do hereby certify that on the about 4th day of June, 19 73, I found evidence of the West 1/4 corner of Section 7 Township 31 N, North, Range 14 E, Fourth, Principal Meridian, as described hereon; and that from this evidence I established a new monument and accessories as described hereon to perpetuate the original location of this corner.

History of original corner establishment:

See History of retracement as stated on Index Number _____ for teh southeast corner of Section 7.


Description of corner evidence found:

No evidence of original corner or bearing trees. Lands cutover. North-south fence line meanders indecisively. East - west fence wanders to the east.] Set corner to match said evidence, from aerial mapping, proportionate measurements along west line.

Resident witnesses:


as shown on the tie sketch.

FORM 985 M. C. MILLER CO., MILWAUKEE

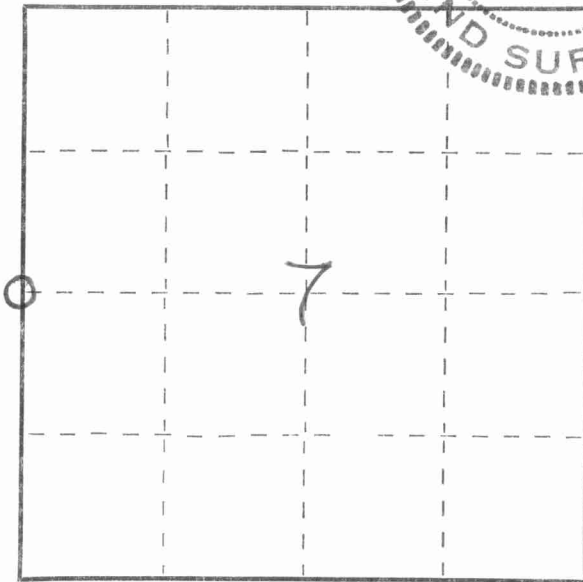

○ = Corner monument restored.

Description of monument and accessories I established to perpetuate the original location of this corner.

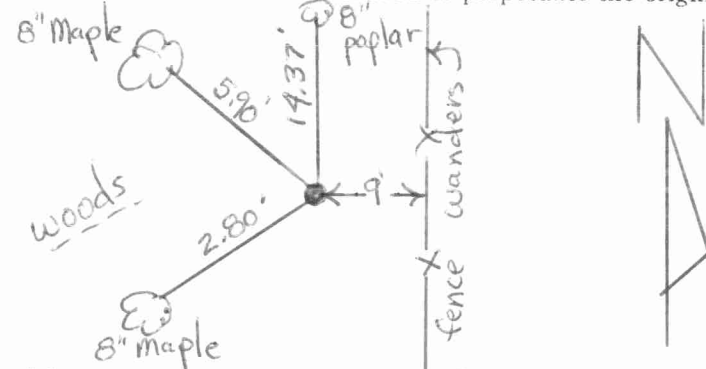

12" exposed, 2"x30" iron pipe 3.65#/ft.
trees blazed. Metal tabs set.
All measurements horizontal

Dated at Wis. Rapids, Wis, this 20th day of May, 19 75

Signature Keith R. Vreeland Title Registered land surveyor Registration No. S-0931
(County Surveyor, Registered Land Surveyor, or other duly authorized official)

Office of Register of Deeds, County of _____, I hereby certify that the within instrument was filed in this office for record on the _____ day of _____, 19 _____ at _____ o'clock _____ M.

(Register of Deeds)

By _____ Deputy

