

CERTIFIED LAND CORNER RESTORATION

Index No. L23

State of Wisconsin }
County of _____ } ss.

I _____, do hereby
certify that on the _____ day
of _____, 19____, I found
evidence of the _____
corner of _____
Township _____, North, Range
_____, Fourth Principal Meridian,
as described hereon; and that from this evidence
I established a new monument and accessories
as described hereon to perpetuate the original
location of this corner.


Resident witnesses:

~~History of original corner establishment:~~

- I. F.H. Copp R.L.S.-799 do hereby certify that in the partial subdivision of Section 13, T31N, R13E, the following corners were set.
- (1)...Set 1 1/4" O.D. Iron Pipe, BTs Cedar 5" N60°E 13.28', Cedar 6" N40°W 13.22'
 - (2)...Set 3/4" Iron Rod 5.0' South of centerline S.T.H."64" BTs 4"X4" Concrete Post N16°W 108.22' 4"X4" Concrete Post S40°W 74.95'
 - * (3)...Set 1 1/4" O.D. Iron Pipe, BTs Cedar 9" N09°E 2.85', Cedar 6" N85°W 20.65'
 - (4)...Set 1 1/4" Iron Pipe in Creek, BTs Cedar 6" N35°E 27.88', Cedar 14" S06°E 28.35'
 - ~~Description of corner evidence found~~
 - (5)...Set 3/4" Iron Rod 7.50' South of centerline S.T.H."64" BTs 4"X4" Concrete Post S24°W 59.00', 4"X4" Concrete Post N12°W 109.30'
 - (6)...Set 1 1/4" O.D. Iron Pipe near centerline of Townline Road BTs Willow 10" N30°E 48.25' (south of three) Tamarack 18" S50°E 47.90' (pipe is 2" below surface of the road.
 - (7)...Set 1 1/4" O.D. Iron Pipe in low spot BTs A.B. 6" S47°W 36.85', Elm 7" N66°W 19.00'
- * Monument is 50'± North of the Evergreen River.

~~Description of monument and accessories I established to perpetuate the original location of this corner.~~

FORM 985 H. C. MILLER CO., MILWAUKEE

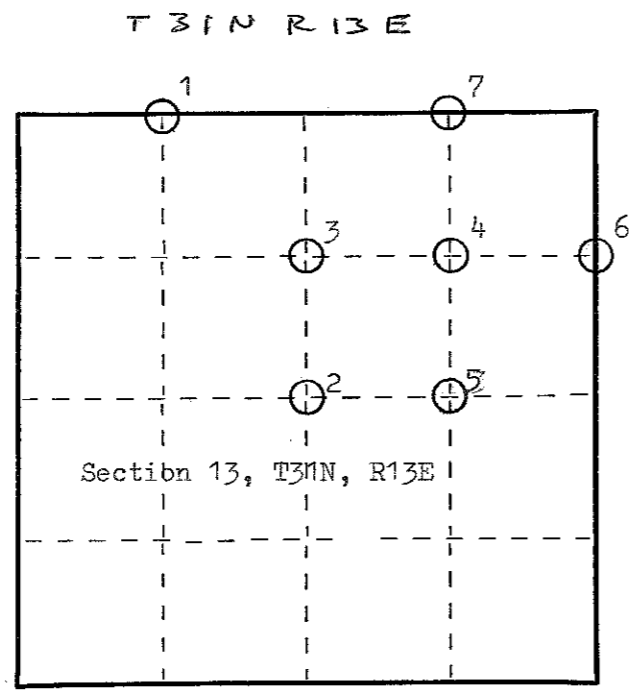

○ = Corner monument restored.



Norbert L. Vissers	Crew Chief
Kenneth V. Freund	Assistant
Gerald Kryka Jr.	Assistant
William Krochmalski	Assistant

Dated at Boulder Junction, Wis., this 4th day of September, 1980

Signature F.H. Copp Title Registered Land Surveyor Registration No. S-799
(County Surveyor, Registered Land Surveyor, or other duly authorized official)

Office of Register of Deeds, County of _____, I hereby certify that the within instrument was filed in this office for record on the _____ day of _____, 19____ at _____ o'clock _____ M.

(Register of Deeds)
By _____ Deputy