

CERTIFIED LAND CORNER RESTORATION

31-13

Index No. K-21

State of Wisconsin }
County of LANGLADE } ss.

I, ROBERT J. POSS, do hereby certify that on the 18TH day of JULY, 19 70, I found evidence of the N 1/16 corner of SECS. 13 & 14 Township 31, North, Range 13 EAST, Fourth, Principal Meridian, as described hereon; and that from this evidence I established a new monument and accessories as described hereon to perpetuate the original location of this corner.

History of original corner establishment:



Description of corner evidence found:

FOUND REMAINS OF OLD SQUARED STAKE
PROBABLY SET BY TIMBER CO. OR ORIGINAL SUBDIVISION.


Resident witnesses:

ALFRED BUETTNER

ARNOLD BUETTNER

Description of monument and accessories I established to perpetuate the original location of this corner.

SET 1 1/4" GALV. PIPE W/ GALV. CAP MKD N 1/16
SEC. 14 - SEC. 13
T 31 N R 13 E

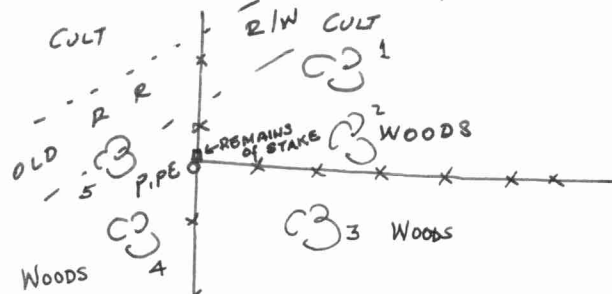

- 1= HD. MAPLE 6 N 36 1/2 E 18.3
- 2= HD. MAPLE 4 N 62 E 12.7 (W. BLUE MK)
- 3= TWIN HD. MAPLE 6 S 57 E 12.3.
- 4= HO. MAPLE 4 S 62 W 14.8
- 5= ASH 12 N 54 W 18.5


Dated at ELCHO, Wis., this 30TH day of JULY, 19 70.

Signature Robert J. Poss Title REG. LAND SURVEYOR Registration No. S-0001
(County Surveyor, Registered Land Surveyor, or other duly authorized official)

Office of Register of Deeds, County of _____, I hereby certify that the within instrument was filed in this office for record on the _____ day of _____, 19 _____ at _____ o'clock _____ M.

(Register of Deeds)

By _____ Deputy

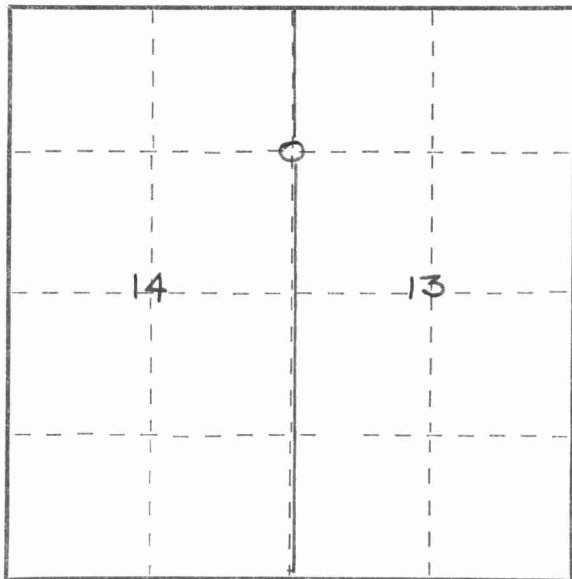

○ = Corner monument restored.

