


PRESERVATION OF LANDMARKSPAGE L-13

SECTION 59,635(7) WISCONSIN STATUTES
 COUNTY LANGLADE
 TOWN EVERGREEN
 HIGHWAY ST.H. 64
 SECTION NO. 16
 T. 31 N., R. 13 E.
 TYPE OF LANDMARK 1/4 CORNER
 LOCATION INDICATED ON SKETCH X

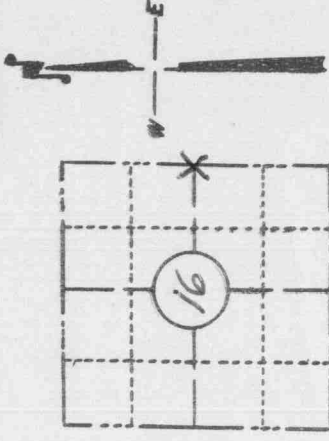

LOCATION SKETCH

Project 50191(6)

242 243
 CENTER LINE OF NEW STH. 64

WITNESS MONUMENTS
 4" X 4" CONCRETE POSTS
 WITH BRASSCAP.

50.0'

50.0'

1/4 CORNER

1/2" X 24" IRON PIN

APPROX. 1' BELOW PAVEMENT.

OLD STH 64

BLACK TOP OBLITERATED

TWIN ROAD

This space for copy of field notes or ties to the above described landmarks

Field notes or records filed in book no. FIELD BOOK No. 4 - P. 62, 63
 at the STATE HIGHWAY COMMISSION OF WISCONSIN office.
 City of RHINELANDER, ONEIDA County.

Located or established by H. M. GOTCHY, 19 , 19 ,
 Title PROJ. ENGR.

County Clerk's Office Langlade County, Wis. }
 Received for record Boh7, 1964

Copy sent to County Surveyor , 19

 County Clerk

31-13
 L-13

