

CERTIFIED LAND CORNER RESTORATION

31-13

Index No. L-9

State of Wisconsin }
County of LANGLADE } ss.

I, ROBERT J. POSS, do hereby certify that on the 8TH day of MAY, 1971, I found evidence of the EAST 1/4 corner of SEC. 17 Township 31, North, Range 13 EAST, Fourth, Principal Meridian, as described hereon; and that from this evidence I established a new monument and accessories as described hereon to perpetuate the original location of this corner.

History of original corner establishment:

OFFSET BY WHC. CREW IN ROAD RECONSTR.



Description of corner evidence found:



FOUND REF. MARKERS SET BY WIS. HWY DEPT.
FOUND BRASS PLUGS IN CONC. MON. SET FLUSH

Resident witnesses:

.....
.....
.....

Description of monument and accessories I established to perpetuate the original location of this corner.

SET 1/4" PIPES (2) MKD E 1/4 COR
GALV. TOP WIT COR
SEC. 17

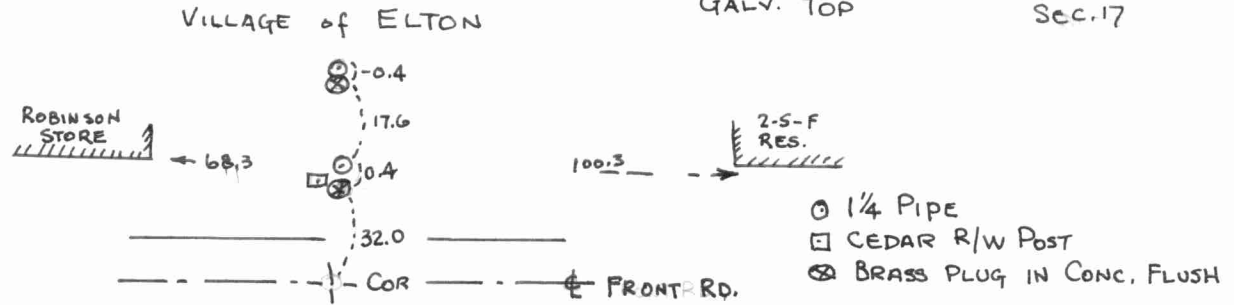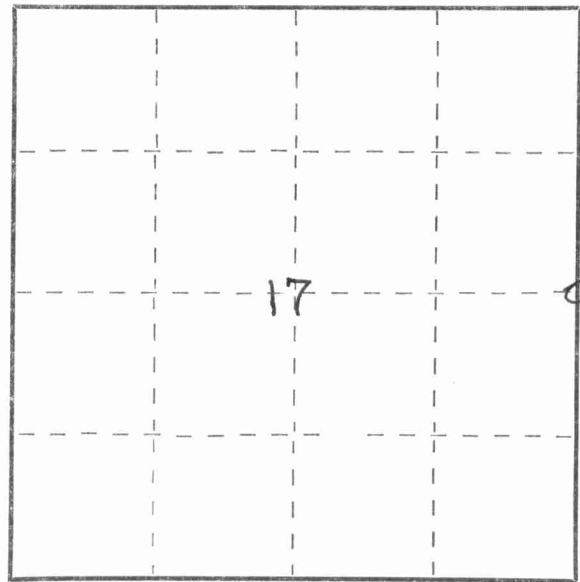

Dated at ELCHO, Wis., this 7TH day of JUNE, 1971

Signature Robert J. Poss Title REG. LAND SURVEYOR Registration No. S-0001
(County Surveyor, Registered Land Surveyor, or other duly authorized official)

Office of Register of Deeds, County of....., I hereby certify that the within instrument was filed in this office for record on the..... day of....., 19..... at..... o'clock..... M.

.....
(Register of Deeds)

By..... Deputy

○ = Corner monument restored.

