

CERTIFIED LAND CORNER RESTORATION


Index No. R-1
T 31 N R 13 E

State of Wisconsin }
County of Langlade } ss.

I, Raymond J. Hallisy, do hereby certify that on the 25th day of OCTOBER, 1986, I found evidence of the SECTION corner of 24, 25, 19, 30 Township 31, North, Range 12 & 13 E, Fourth Principal Meridian, as described hereon; and that from this evidence I established a new monument and accessories as described hereon to perpetuate the original location of this corner.

Resident witnesses:

.....
.....
.....

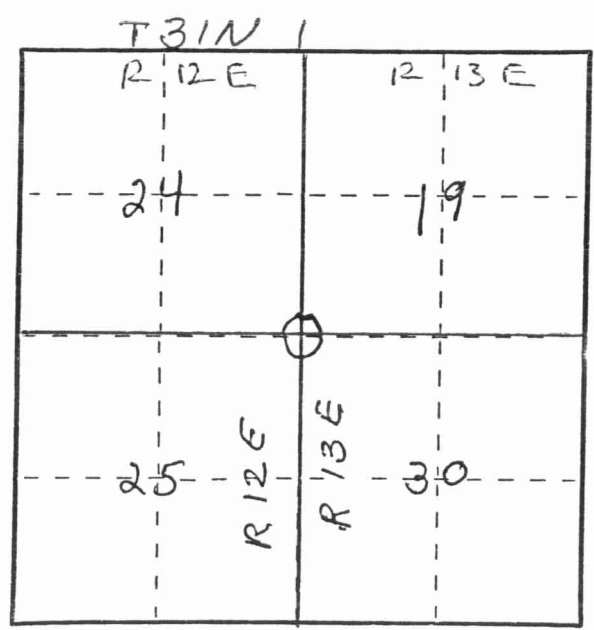

○ = Corner monument restored.

History of original corner establishment:

Description of corner evidence found:

4" BRASS CAP IN 2" IRON PIPE
IN Cement
MARKED →
Fence south



Description of monument and accessories I established to perpetuate the original location of this corner.

New BT's
Red maple 7" N 76 E 9' 3"
" " 10" S 84 W 26' 1"
Balsam 7" N 4° W 10' 1"
Red maple 7" N 70 W 20' 8"

Dated at Antigo, Wis., this 25th day of OCTOBER, 1986

Signature Raymond J. Hallisy Title Land Surveyor Registration No. 5685
(County Surveyor, Registered Land Surveyor, or other duly authorized official)

Office of Register of Deeds, County of....., I hereby certify that the within instrument was filed in this office for record on the.....day of....., 19..... at.....o'clock..... M.

.....
(Register of Deeds)

By.....Deputy

FORM 985 M. C. MILLER CO., MILWAUKEE

