

# U.S. PUBLIC LAND SURVEY MONUMENT RECORD

(Prepared and as required by S. A-E 7.08 WI Administrative Code)

The C 1/4 corner of Section 24, T. 31 N., R. 13 E., Langlade County, WI

Corner was: (check all that apply)

- Restored through acceptance of an obliterated evidence location.
- Restored through acceptance of a found perpetuated location.
- Determined to be lost and re-established through proportionate methods.
- (Show bearings and distances to PLS corners used for proportioning.)
- Restored/recovered/reestablished in a location that differs from a previously established position. (Show difference in plan view below.)

Check here if additional information is shown on the reverse side of this form.

Describe record evidence, recovered physical evidence, occupational evidence, testimonial evidence and all other evidence considered in the recovery/restoration of the corner.

MALCOM HUTCHINSON 1900± ORIG. SUBDIVIDED SECTION 24, SET 2 NEW BT'S:  
 SUGAR 14 S9E 18' SUGAR 14 N84W 31 1/2'.  
 GARY A. RADTKE SET C 1/4 1978, SET 3 NEW BT'S, SAYS FOUND 1 OLD BT.  
 TOM ARNOTT SUBDIVIDED SECTION 24 IN 2001, COMPUTED C 1/4.  
 DEANA WILLIAMS CONTRACTED TO SET C 1/4 ON STRAIGHT LINE INTERSECTION  
 BUT DAVE TLUSTY FOUND OLD BT: SUGAR 14 S9E 18' IKS. (11.88')  
 DEANA WILLIAMS 2002 USED OLD BT TO RETIE GARY A. RADTKE'S MONUMENT  
 TO THE CORRECT POSITION. DID NOT FIND OR USE RADTKE'S BT'S.

Physical description of the monument set:  
**ACCEPTED GARY A. RADTKE'S MONUMENT STRAIGHTENED AND RESET.  
 SET 4 NEW 3/4" x 30" REBAR WITNESSES AND A WHITE VINYL POST 1.0' NORTH.**


Describe the accessories used to perpetuate the location of the corner. Include a plan view drawing and indicate accessories found/set. Describe measuring point on bearing trees. Show any topographic features that would aid in future recovery of the corner.

SCALE 1" = 100'

MAG. BEARINGS

• - 3/4" x 30" REBARS


○ - OLD BT W/ FACE BLAZE

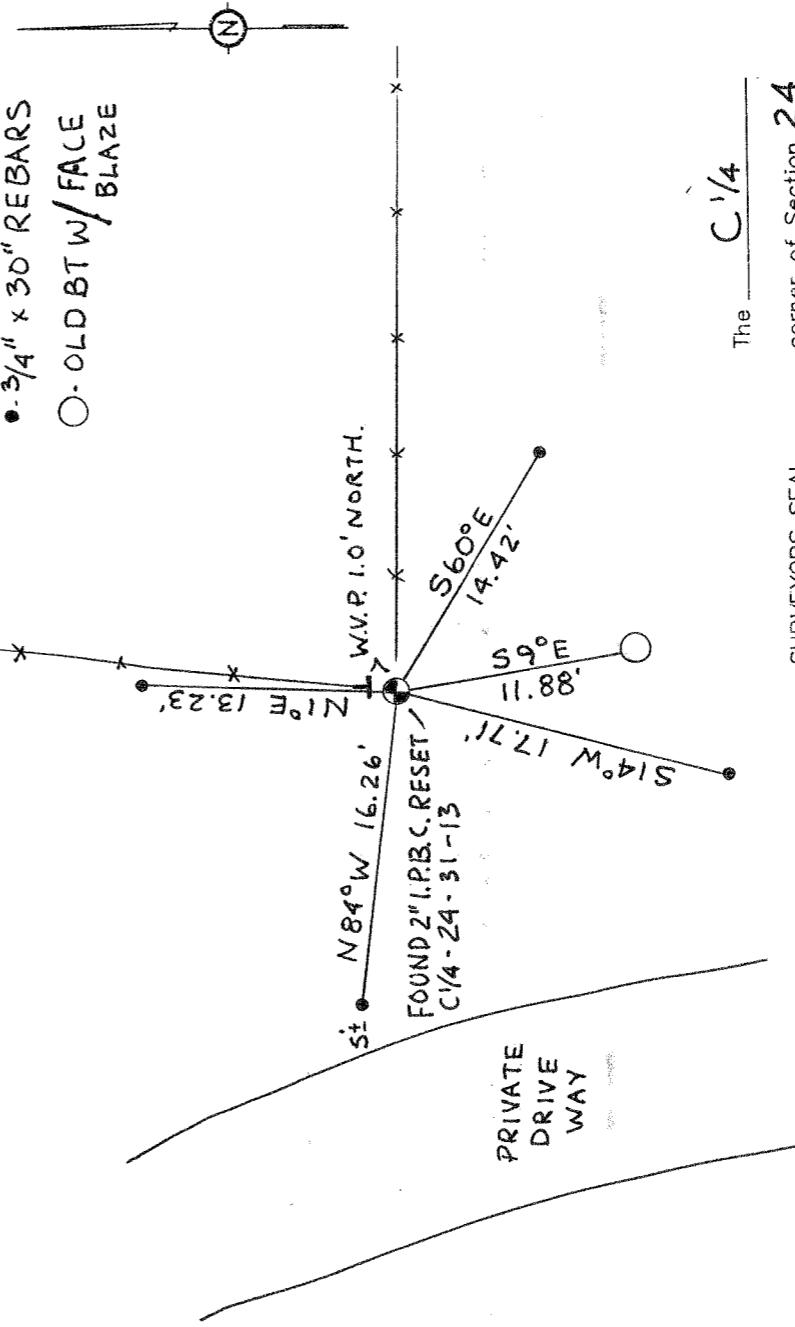

SURVEYORS SEAL

corner of Section 24

T. 31 N., R. 13 E.  
 Langlade County, WI

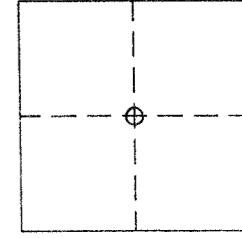

○ = Location of corner

I, DEANA WILLIAMS RLS-2468, certify that the corner location shown on this record was determined by me or under my direction and control and that this U.S. Public Land Survey Monument Record is correct and complete to the best of my knowledge and belief.



5/13/2002

Date

Signature

P23

INDEX No.

WISCONSIN ADMINISTRATIVE CODE

Note: A copy of the board-approved form is available from the Department of Registration and Licensing, Bureau of Business and Design Professions, 1400 East Washington Avenue, P.O. Box 3935, Madison, Wisconsin 53708.

(3) MONUMENT RECORD REQUIREMENTS. A U.S. public land survey monument record shall show the location of the corner and shall include all of the following elements:

(a) The identity of the corner, as referenced to the U.S. public land survey system;

(b) A description of any record evidence, monument evidence, occupational evidence, testimonial evidence or any other material evidence considered by the surveyor, and whether the monument was found or placed;

(c) Reference ties to at least 4 witness monuments. Witness monuments shall be concrete, natural stone, iron, bearing trees or other equally durable material, except wood other than bearing trees;

(d) A plan view drawing depicting the relevant monuments and reference ties which is sufficient in detail to enable accurate relocation of the corner monument if the corner monument is disturbed;

(e) A description of any material discrepancy between the location of the corner as restored or reestablished and the location of that corner as previously restored or reestablished;

(f) Whether the corner was restored through acceptance of an obliterated evidence location or a found (perpetuated) location;

(g) Whether the corner was reestablished through lost-corner-proportionate methods;

(h) The directions and distances to other public land survey corners which were used as evidence or used for proportioning in determining the corner location; and,

(i) The stamp and signature or seal and signature of the land surveyor under whose direction and control the corner location was determined and a statement certifying that the U.S. public land survey monument record is correct and complete to the best of his or her knowledge and belief.

History: Cr. Register, February, 1987, No. 374, eff. 3-1-87; am. (1) and (3)(c), Register, May, 1989, No. 461, eff. 6-1-89.

