

CERTIFIED LAND CORNER RESTORATION

31-13
Index No. T-7


State of Wisconsin }
County of Langlade } ss.

I, Raymond J. Hallisy, do hereby certify that on the 19th day of April, 1969, I found evidence of the center of Section 29 corner of Section 29 Township 31 N, Range 13 E, Fourth Principal Meridian, as described hereon; and that from this evidence I established a new monument and accessories as described hereon to perpetuate the original location of this corner.

Resident witnesses:

Max Johnson

FORM 985 H. C. MILLER CO., MILWAUKEE

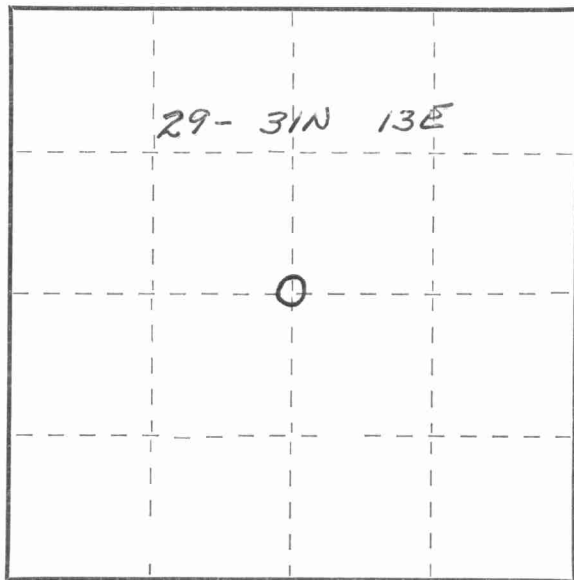

○ = Corner monument restored.

History of original corner establishment:

Corner set by M. Hutchinson on October 21, 1909
Scribed post
B.T. - Sugar maple 10" S86³/₄° E 11¹/₄ lks.


Description of corner evidence found:

B.T. - No evidence
Found upper 1/2 of corner post. One face scribed C/S

Description of monument and accessories I established to perpetuate the original location of this corner.

Corner: 2" iron pipe with brass cap marked C/S 29 T 31 N R 13 E. Erected rock mound.
B.T.s / Sugar maple 8" N88° E 12 ft. 4in.

2 Sugar maple 6" S 16° W 10 ft.
3 Twin yellow birch clump 5" each N 21° W 21 ft. 10in.
Trees scribed with B T

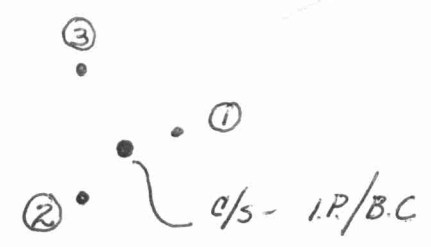

Dated at Antigo, Wis., this 21 day of April, 1969

Signature: Raymond J. Hallisy Title Reg. Land Surveyor Registration No. S-685
(County Surveyor, Registered Land Surveyor, or other duly authorized official)

Office of Register of Deeds, County of _____, I hereby certify that the within instrument was filed in this office for record on the _____ day of _____, 19____ at _____ o'clock _____ M.

(Register of Deeds)

By _____ Deputy

