

CERTIFIED LAND CORNER RESTORATION

Index No. C-13


State of Wisconsin }
County of LANGLADE } ss.

I WILLIAM F. KELLY, do hereby certify that on the 15th day of MARCH, 1983, I found evidence of the CENTER corner of SECTION 1 Township 31, North, Range 14 EAST, Fourth Principal Meridian, as described hereon; and that from this evidence I established a new monument and accessories as described hereon to perpetuate the original location of this corner.

Resident witnesses:

.....
.....
.....

FORM 985 M. C. MILLER CO., MILWAUKEE

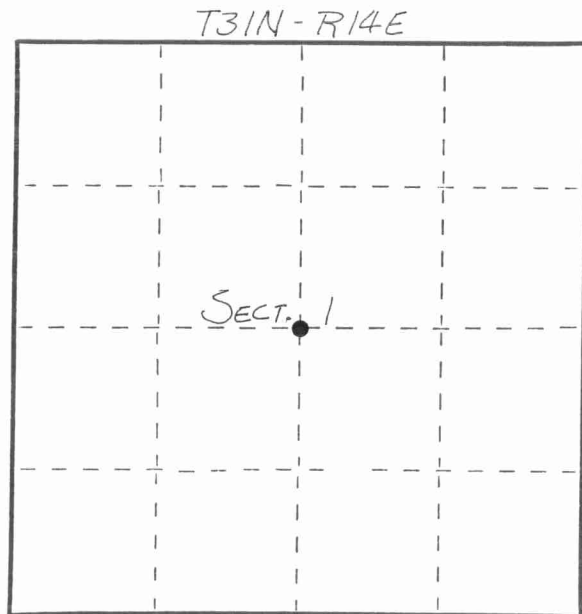


○ = Corner monument restored.

History of original corner establishment:

CORNER NOT ESTABLISHED DURING ORIGINAL GOV'T SURVEY.


Description of corner evidence found:

2" x 36" ALUMINUM MONUMENT SET AT INTERSECTION OF N-S & E-W 1/4 LINES OF SECTION 1. Work Done By John Fisher In Oct 1982

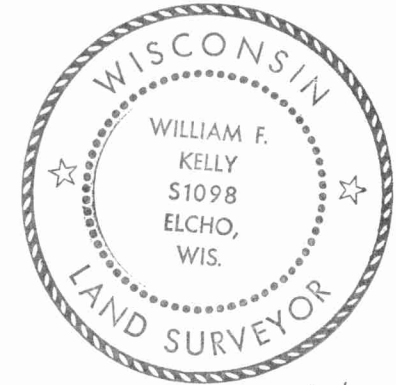

William F. Kelly

Description of monument and accessories I established to perpetuate the original location of this corner.

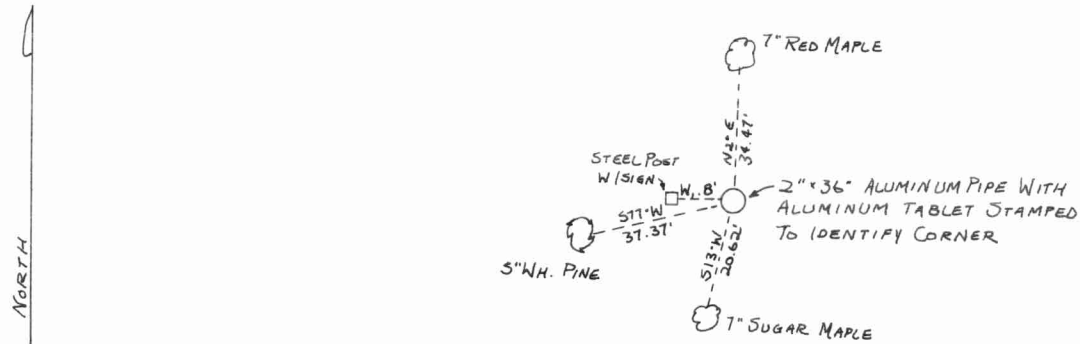

Dated at ELCHO, Wis., this 15th day of MARCH, 1983

Signature William F. Kelly Title COUNTY SURVEYOR Registration No. 1098
(County Surveyor, Registered Land Surveyor, or other duly authorized official)

Office of Register of Deeds, County of _____, I hereby certify that the within instrument was filed in this office for record on the _____ day of _____, 19____ at _____ o'clock _____ M.

.....
(Register of Deeds)

By _____ Deputy

