

CERTIFIED LAND CORNER RESTORATION

31-14  
Index No. C-21

State of Wisconsin }  
County of Lanlade } ss.

History of original corner establishment:

I Raymond J. Hallisy, do hereby certify that on the 5th day of May, 1969, I found evidence of the W. 1/4 corner of Section 1 Township 31, North, Range 14E, Fourth, Principal Meridian, as described hereon; and that from this evidence I established a new monument and accessories as described hereon to perpetuate the original location of this corner.

Description of corner evidence found:


**Found old squared scribed stake in rock mound. Location tag on tree.**  
**No visible BT's**

Resident witnesses:

.....  
.....  
.....

Description of monument and accessories I established to perpetuate the original location of this corner.

**Set 4" brass cap in cement**  
**B.T.'s to corner**  
Oak 6" N46E 30ft. 10 inches  
Red maple 7" S88W 18ft. ~~18~~ 8 inches  
**B.T.'s faced at base of tree and scribed BT**

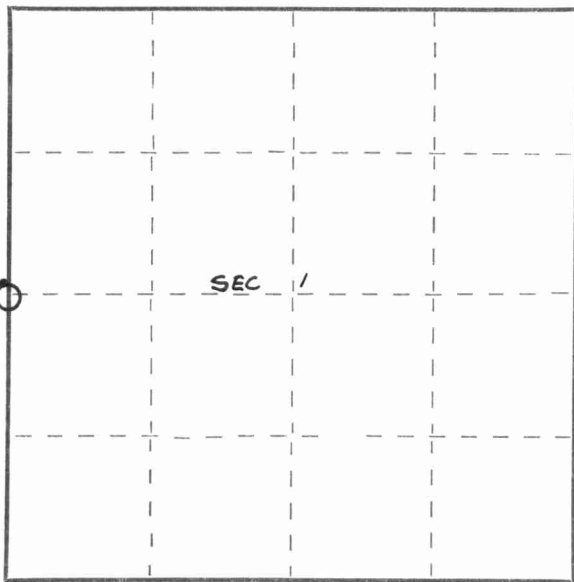

○ = Corner monument restored.

Dated at Antigo, Wis., this 5th day of May, 1969.

Signature Raymond J. Hallisy Title Reg. Land Surveyor Registration No. S-685  
(County Surveyor, Registered Land Surveyor, or other duly authorized official)

Office of Register of Deeds, County of \_\_\_\_\_, I hereby certify that the within instrument was filed in this office for record on the \_\_\_\_\_ day of \_\_\_\_\_, 19\_\_\_\_ at \_\_\_\_\_ o'clock \_\_\_\_\_ M.

.....  
(Register of Deeds)

By \_\_\_\_\_ Deputy

10-