

# U.S. PUBLIC LAND SURVEY MONUMENT RECORD

**Note:** This form is intended and designed to fulfill all requirements of Wisconsin Administrative Code, Chapter A-E 7.08 U.S. Public Land Survey Monument Record (3) (a) (b) (c) (d) (e) (f) (g) (h) (i). An additional sheet may be added if necessary to conform with said requirements.

(a) Corner location: Township 31 North

Range 14 East/West


Town/City/Village Wolf River

County Langlade

Section 7


(b) (f) (g) (h) Description of monument found at this corner and if it was accepted, state all evidence (material, testimonial, occupational, plats, records, other monuments) used as a basis for accepting. If not accepted or if nothing was found, state evidence used as basis for establishing location. If reestablished through lost corner proportionate methods, indicate all monuments, distances and directions used to establish. Indicate type of monument found or set and sign post.

- 9/1857 - James McBride established this corner at 80.00 chains, set wood post and four BTs:  
 6" Elm, N18°E, 24 Links (15.84')    7" Hemlock, S81°E, 76 Links (50.16')  
 15" Sugar, S21°W, 59 Links (38.94')    6" Elm, N48°E, 37 Links (24.42')
- 7/9/1992 - Milo E. Stefan found 1 1/2" x 30" iron pipe with remains of original Elm BT, N18°E, 15.8'. Also, butt off of local BT with face blaze to iron pipe. Location poster by Paper Company.

I accept this iron pipe as the perpetuated position of the original GLO Corner and placed an aluminum monument and made four new BTs.

(c) (d) (e) Plan view of corner with ties to at least 4 witness monuments. If in disagreement with previously established corner, show the distances between the two corners and also indicate the ties to the disputed corner.

- 1) 2" x 42" Aluminum monument in mound of stone.
  - 2) 10" Yellow Birch, N22°E, 40.56'.
  - 3) 12" Sugar Maple, S2°W, 36.00'.
  - 4) 5" Sugar Maple, N87°W, 14.45'.
  - 5) 10" Sugar Maple, S65°E, 15.34'.
  - 6) 5' x 5' x 4' High pink granite boulder/"+" on top, S80°W, 89.99'.
  - 7) Plastic sign post, North, .8'.
- Distances to nail in side of BTs.  
 Stump blaze scribed "BT".

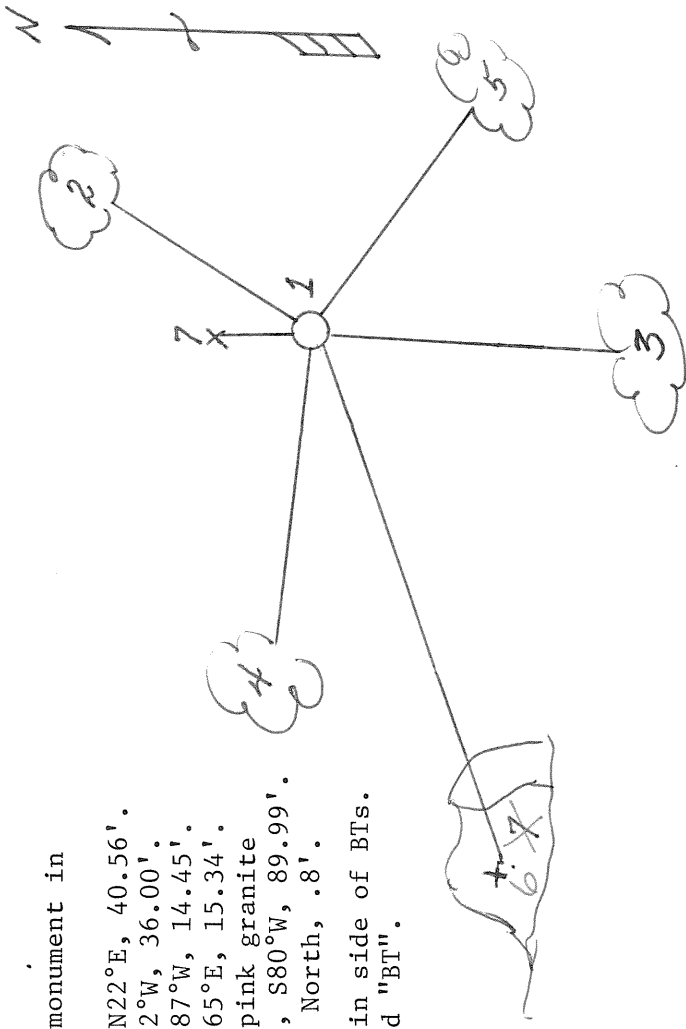

(i) I, Milo E. Stefan

(type or print name) certify that the corner location on this record was determined by me or under my direction and control and that this U.S. Public Land Survey Monument Record is correct and complete to the best of my knowledge and belief.

Milo E. Stefan

Signature

July 15, 1992

Date



Stamp