


# U.S. PUBLIC LAND SURVEY MONUMENT RECORD

Note: This form is intended and designed to fulfill all requirements of Wisconsin Administrative Code, Chapter A-E 5.02, U.S. Public Land Survey Monument Record (3) (a) (b) (c) (d) (e) (f) (g) (h) (i). An additional sheet may be added if necessary to conform with said requirements.

(a) Corner location: Township 31 North

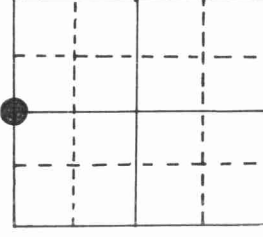

Section 18

Range 14 East/West

Town/City/Village Wolf River

County Langlade

(b) (f) (g) (h) Description of monument found at this corner and if it was accepted, state all evidence (material, testimonial, occupational, plats, records, other monuments) used as a basis for accepting. If not accepted or if nothing was found, state evidence used as basis for establishing location. If reestablished through lost corner proportionate methods, indicate all monuments, distances and directions used to establish.


Original by J. McBride, 1857, (at 42.10 ch), OBT's bir 14°N12°W 14 lks., map 10°S10°E 10 lks

K. Vreeland set cor. in 1974 for Big Valley Plat.

B. Kelly used cor. in 1979 to make CSM V.2, p.11.

Seymour, in 1991 could not find cor. as road construction in about 1988 probably took it out. I set an aluminum monument using Kelly's CSM V.2, p.11, by prolonging the line from NW 18 thru Kelly's W1/16 and double the distance as he set the W1/16 at ½ way. The W1/16 should have been set by proportion to orig. plat.

(c) (d) (e) Plan view of corner with ties to at least 4 witness monuments. If in disagreement with previously established corner, show the distances between the two corners and also indicate the ties to the disputed corner.

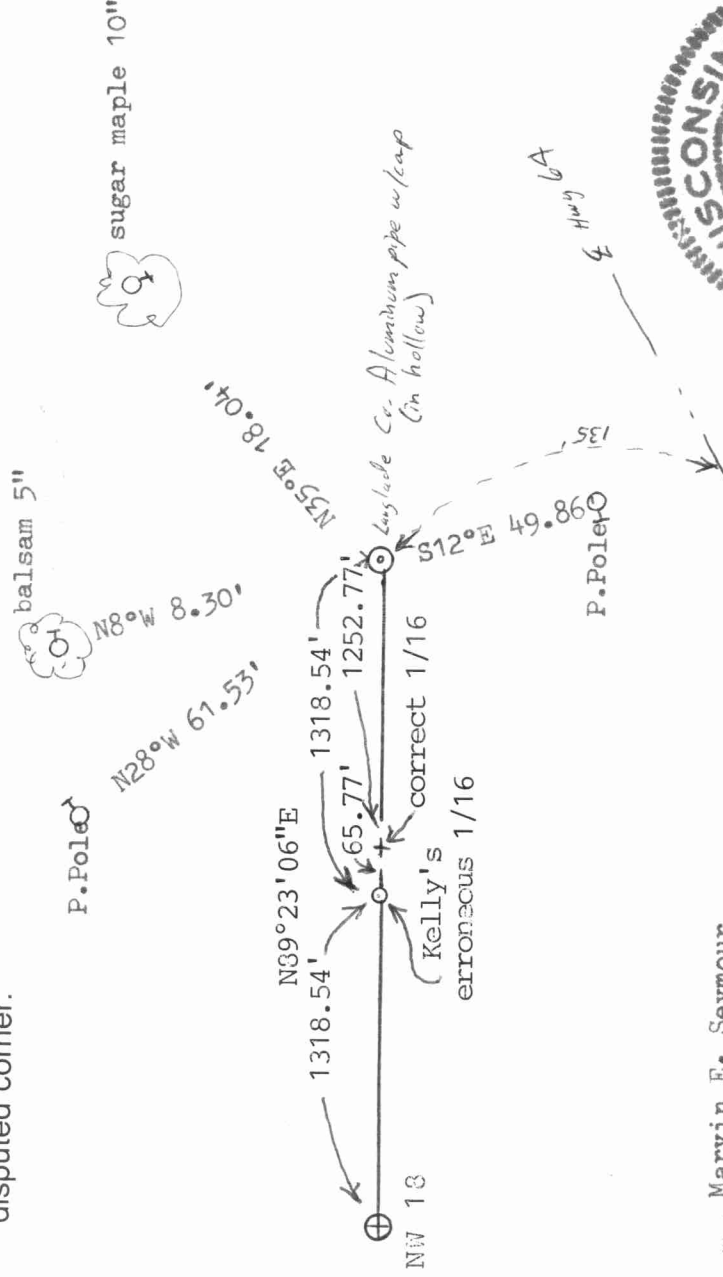

(i) I, Marvin E. Seymour  
 (type or print name) certify that the corner location on this record was determined by me or under my direction and control and that this U.S. Public Land Survey Monument Record is correct and complete to the best of my knowledge and belief.



Marvin E. Seymour July 26, 1991  
 Signature Date

