

# U.S. PUBLIC LAND SURVEY MONUMENT RECORD


Note: This form is intended and designed to fulfill all requirements of Wisconsin Administrative Code, Chapter A-E 7.08 U.S. Public Land Survey Monument Record (3) (a) (b) (c) (d) (e) (f) (g) (h) (i). An additional sheet may be added if necessary to conform with said requirements.

(a) Corner location: Township 31 North

Range 14 East/West

Town/City/Village Wolf River

County Langlade

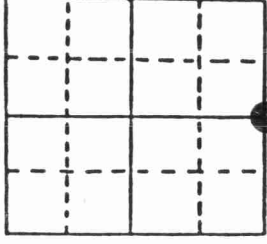

Section 7

(b) (f) (g) (h) Description of monument found at this corner and if it was accepted, state all evidence (material, testimonial, occupational, plats, records, other monuments) used as a basis for accepting. If not accepted or if nothing was found, state evidence used as basis for establishing location. If reestablished through lost corner proportionate methods, indicate all monuments, distances and directions used to establish. Indicate type of monument found or set and sign post.

9/1857 - James McBride established this corner at 42.10 chains, set wood post and made two BTs:

14" Birch, N12°W, 14 Links (9.24') 12" Sugar, S10°E, 10 Links (6.60')

6/14/1898 - Dorr found Birch BT down with scribe marks visible while running traverse for road from Langlade to Antigo. He made one new BT:

12" Sugar, S52°W, 63 3/4 Links (40.08')

11/16/1913 - Brooks found Dorr's BT and set stone with "+" and new BT:

14" Sugar, S17½°W, 63½ Links (41.75') Stone: 8" x 12" x 18"

6/1973 - Vreeland set 2" iron pipe.

5/1979 - Kelly used Vreeland pipes to set West Sixteenth.


6/1991 - Seymour found corner destroyed and restored it by extension of line from Section Corner through West Sixteenth and set 2" aluminum monument.

6/25/1992 - Milo E. Stefan found Seymour's monument in place. Upon investigation and evaluation of past surveys by Dorr, Brooks and Webly, I disregard recent

(c) (d) (e) Plan view of corner with ties to at least 4 witness monuments. If in disagreement with previously established corner, show the distances between the two corners and also indicate the ties to the disputed corner.

work by Vreeland, Kelly and Seymour and restore this corner by extension of the North - South Quarter Line through Section 18. South Quarter and Center Quarter Corners of Section 18 are proven good. A fence line in poor state of repair is present along this Quarter Line from the South Quarter to a R-O-W Post about 200' South of this Quarter Corner.

This position is in harmony with distances returned by Dorr to the West and East in his Highway Survey. We placed an aluminum monument and made four new BTs.

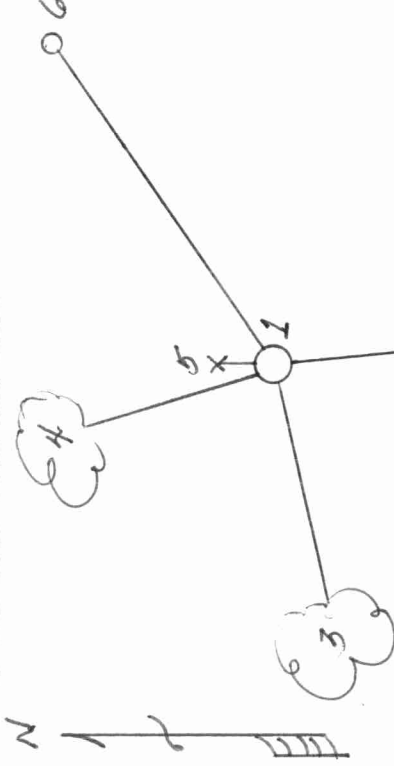

- 1) 2" x 42" Aluminum monument.
- 2) 14" Red Pine, S2°E, 190.97'.
- 3) 12" Sugar, S82°W, 30.59'.
- 4) 16" Sugar, N10°W, 24.27'.
- 5) Plastic sign post, North, .7'.
- 6) Seymour's Monument, N52°-04'-26"E, 103.35'.

Distances to nail in side of BTs.  
Stump blaze scribed "BT".

(i) Milo E. Stefan

(type or print name) certify that the corner location on this record was determined by me or under my direction and control and that this U.S. Public Land Survey Monument Record is correct and complete to the best of my knowledge and belief.

*Milo E. Stefan*

Signature

July 15, 1992

Date



Index No. J-3

Stamp

